

STATE ENGINEER
Salem, Oregon

*MARION...
13899
MARION*

Well Record

STATE WELL NO. 9/2W-3P(1)
COUNTY Marion
APPLICATION NO. GR-1115

GR- 1075

OWNER: D. B. Maxfield

MAILING ADDRESS: Rt. 1, Box 27


LOCATION OF WELL: Owner's No. _____

CITY AND STATE: Turner, Oregon

SE 1/4 SW 1/4 Sec. 3 T. 9 S., R. 2 W., W.M.

Bearing and distance from section or subdivision

corner 1000' N. & 2200' E. from SW cor. Sec. 3.

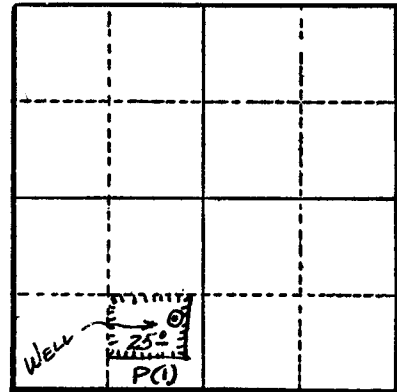

Section 3

Altitude at well 330 ft.

TYPE OF WELL: Drilled Date Constructed 1953

Depth drilled 50 ft. Depth cased 50 ft.

CASING RECORD:

10 inch

FINISH:

Mills knife perforations - no record of depths

AQUIFERS:

WATER LEVEL:

8 ft.

PUMPING EQUIPMENT: Type Submersible H.P. 10

Capacity 100 G.P.M.

WELL TESTS:

Drawdown 49 ft. after _____ hours 100 G.P.M.

Drawdown _____ ft. after _____ hours _____ G.P.M.

USE OF WATER Irrigation Temp. _____ °F., 19_____

SOURCE OF INFORMATION G. R. Record

DRILLER or DIGGER Sneed Bros.

ADDITIONAL DATA:

Log N.A.A. Water Level Measurements _____ Chemical Analysis _____ Aquifer Test _____

REMARKS:

Irrigation of 25 acres.