

STATE ENGINEER
Salem, Oregon

MAR 1954
13924
MAR 1954
Well Record

STATE WELL NO. 9/2W-4K
COUNTY MARION
APPLICATION NO. GR-2551

OWNER: Joseph A. Holt


MAILING ADDRESS:

LOCATION OF WELL: Owner's No.

CITY AND STATE: Turner, Oregon

NW 1/4 SE 1/4 Sec. 4 T. 9 S., R. 2 W., W.M.

Bearing and distance from section or subdivision corner 210' E and 610' S from Center of Section 4

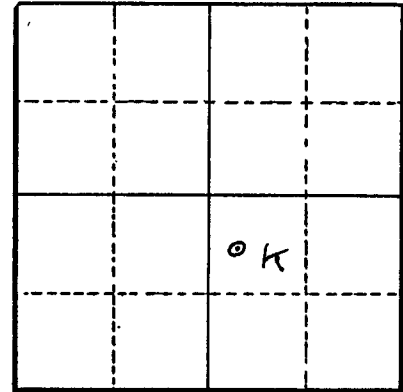

Section 4

Altitude at well

TYPE OF WELL: Drilled Date Constructed 1953

Depth drilled 51' Depth cased 51'

CASING RECORD:

8-inch

FINISH:

AQUIFERS:

dirt, gravel, sand; hard pan, loose gravel

WATER LEVEL: 6'

PUMPING EQUIPMENT: Type

H.P. 7

Capacity 100 G.P.M.

WELL TESTS:

Drawdown ft. after hours G.P.M.

Drawdown ft. after hours G.P.M.

USE OF WATER Irrigation

Temp. °F., 19

SOURCE OF INFORMATION GR-3898

DRILLER or DIGGER

ADDITIONAL DATA:

Log Water Level Measurements Chemical Analysis Aquifer Test

REMARKS:

From surface down 23', dirt, gravel and sand; from 23' to 39', hard pan and from 39' to 51' water loose gravel.