

STATE ENGINEER
Salem, Oregon

MARI
13937
MARI

MARI 13937

Well Record

STATE WELL NO. 9/2W-5E
COUNTY Marion
APPLICATION NO. GR-2659

OWNER: A. S. Drager


MAILING ADDRESS: Route 1, Box 272-C

LOCATION OF WELL: Owner's No.

CITY AND STATE: Turner, Oregon

SW 1/4 NW 1/4 Sec. 5 T. 9 S., R. 2 W., W.M.

Bearing and distance from section or subdivision corner 200 ft. E. & 700 ft. N.

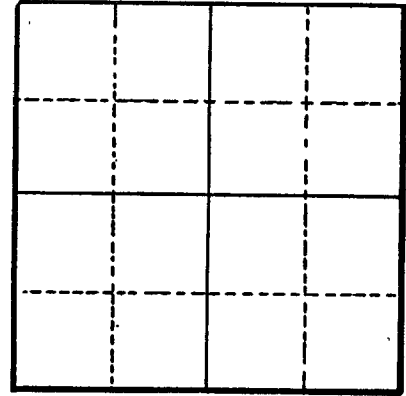

Section

Altitude at well

TYPE OF WELL: drilled Date Constructed 1950

Depth drilled 120' 8" Depth cased 94'

CASING RECORD:

8 inch

FINISH:

AQUIFERS:

gravel, sand, clay, and sandstone

WATER LEVEL:

1 foot

PUMPING EQUIPMENT: Type Berkeley Turbine H.P. 15
Capacity 250 G.P.M.

WELL TESTS:

Drawdown 110 ft. after hours pumping 170 G.P.M.

Drawdown ft. after hours G.P.M.

USE OF WATER irrigation Temp. °F., 19


SOURCE OF INFORMATION GR-2521

DRILLER or DIGGER Duffield Brothers

ADDITIONAL DATA:

Log X Water Level Measurements Chemical Analysis Aquifer Test

REMARKS:

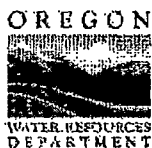

Oregon Water Resources Department
725 Summer Street NE, Suite A
Salem Oregon 97301
(503) 986-0900
www.oregon.gov/owrd

Application for Well ID Number

RECEIVED

FEB 11 2019

Do not complete if the well already has a Well Identification Number.

OWRD

I. OWNER INFORMATION

Current Owner Name (please print): LIANG ZHAO
Mailing Address: 9536 PARRISH GAP RD SE
City, State, Zip: TURNER, OR 97392
Mail Well ID to: SAME AS ABOVE In Care Of (C/O)
Name & Address: _____
City, State, Zip: _____

II. WELL LOCATION INFORMATION (Please fill out as completely as possible)

Township: 9S (North / South) Range: 2U (East / West) Section: 5 SE 1/4 of the NE 1/4
Tax Lot (usually last 3-5 numbers of Tax Map #): 2000 County MARION
GPS Coordinates: _____
Street Address of Well, City: 9536 PARRISH GAP RD SE
If the property had a different street address in the past: _____

III. GENERAL WELL INFORMATION (Please fill out as completely as possible, AND attach copy of Well Report, if available)

Use of Well (domestic, irrigation, commercial, industrial, monitoring): IRRIGATION
Date Well Constructed (or property built): 1950 Total Well Depth: 120 Casing Diameter: 8
Owner at time the well was constructed (if known): A. S. DRYER Well Report # (if known): MARI 13937
Other Information: _____

SUBMITTED BY (please print): DARIN PENNINGTON / MACK DRILLING COMPANY INC
PHONE: 503-371-4399 EMAIL &/or FAX: darin@mackdrilling.com

Send application to: Oregon Water Resources Department 725 Summer St NE, Suite A, Salem, Oregon 97301; or fax to (503) 986-0902. Applications are processed in the order they are received, and Well ID Numbers are mailed within 4-5 business days.

<i>For Official Use Only by the Oregon Water Resources Department:</i>		
Received Date: <u>2-11-19</u>	Well Report Number: <u>MARI 13937</u>	Well Identification #: <u>L-133224</u>