

STATE ENGINEER
Salem, Oregon

M 171.1400

Well Record

STATE WELL NO. 4/2W-35E(1)
COUNTY Marion
APPLICATION NO. GR-1067

GR- 1029

OWNER: Carl A. Magnuson

MAILING ADDRESS: Rt. 1, Box 325


LOCATION OF WELL: Owner's No.

CITY AND STATE: Woodburn, Oregon

SW 1/4 NW 1/4 Sec. 35 T. 4 S., R. 2 W., W.M.

Bearing and distance from section or subdivision

corner 1920' S. & 660' E. of NW cor. of Sec. 35.

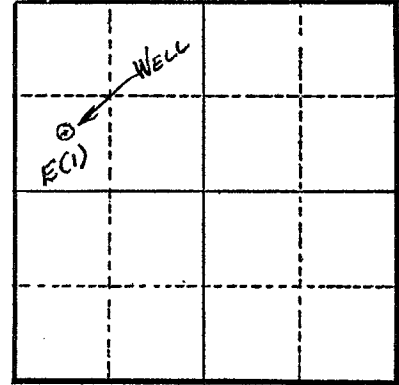

Section 35

Altitude at well 155 ft. ? 170

TYPE OF WELL: Drilled Date Constructed 1952

Depth drilled 81 ft. Depth cased 81 ft.

CASING RECORD:

12 inch I.D. concrete irr. tile.

FINISH:

AQUIFERS:

WATER LEVEL:

21 ft.

PUMPING EQUIPMENT: Type Berkeley turbine H.P. 7 1/2

Capacity 325 G.P.M.

WELL TESTS:

Drawdown 33 ft. after 250 hours G.P.M.

Drawdown 41 ft. after 275 hours G.P.M.

USE OF WATER Irrigation Temp. °F. 19

SOURCE OF INFORMATION G.R. Record

DRILLER or DIGGER Perkins

ADDITIONAL DATA:

Log Water Level Measurements Chemical Analysis Aquifer Test

REMARKS:

Log: Top soil	0 to 3 ft.
Yellow clay & silt (water)	3 to 20 ft.
Blue clay	20 to 80 ft.
Black sand	80 to 81 ft.

Irrigation of 29 acres.