

STATE ENGINEER
Salem, Oregon

MAR 14 1905

Well Record

GR- 1162

STATE WELL NO. 4/2W-36E(1)
COUNTY Marion
APPLICATION NO. GR-1202

OWNER: William A. & Nina Brown


MAILING ADDRESS: Rt. 1, Box 401

LOCATION OF WELL: Owner's No. #2

CITY AND STATE: Aurora, Oregon

SW 1/4 NW 1/4 Sec. 36 T. 4 S., R. 2 W., W.M.

Bearing and distance from section or subdivision corner S. 35° E. 1950' from NW cor. Sec. 36.

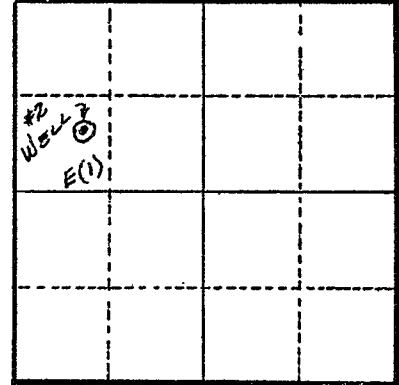

Section 36

Altitude at well 177 ft.

TYPE OF WELL: Drilled Date Constructed 1947

Depth drilled 132 ft. Depth cased 132 ft.

CASING RECORD:

12 inch

FINISH:

AQUIFERS:

WATER LEVEL:

20 ft.

PUMPING EQUIPMENT: Type Pomona turbine H.P. 40
Capacity 700 G.P.M.

WELL TESTS:

Drawdown 90 ft. after hours 700 G.P.M.
Drawdown ft. after hours G.P.M.

USE OF WATER Irrigation Temp. °F. 19

SOURCE OF INFORMATION G. R. Record

DRILLER or DIGGER Vernon Coleman

ADDITIONAL DATA:

Log N. A. Water Level Measurements Chemical Analysis Aquifer Test

REMARKS:

Irrigation of 247.178 acres.