

STATE ENGINEER
Salem, Oregon

Well Record

STATE WELL NO. 9/2W-12K
COUNTY MARION
APPLICATION NO. GR-2575


MARION...
1411/18
MAKE

OWNER: Silas D. Brewston
MAILING ADDRESS: Rt. 1, Box 207 A

LOCATION OF WELL: Owner's No.
CITY AND STATE: Turner, Oregon

NW 1/4 SE 1/4 Sec. 12 T. 9 S., R. 2 W., W.M.

Bearing and distance from section or subdivision
corner 1830' W. and 500' S. from E. Young DLC No. 48

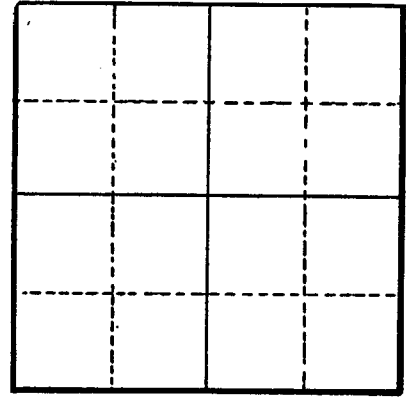

Section

Altitude at well

TYPE OF WELL: Dug Date Constructed 1925

Depth drilled 20 Depth cased

CASING RECORD:

FINISH:

AQUIFERS:

WATER LEVEL:

6-feet

PUMPING EQUIPMENT: Type Chrysler H.P.
Capacity 800 G.P.M.

WELL TESTS:

Drawdown ft. after hours G.P.M.

Drawdown ft. after hours G.P.M.

USE OF WATER Irrigation Temp. °F., 19

SOURCE OF INFORMATION GR-2445

DRILLER or DIGGER Salem Sand and Gravel

ADDITIONAL DATA:

Log Water Level Measurements Chemical Analysis Aquifer Test

REMARKS: