

STATE ENGINEER  
Salem, Oregon

# Well Record

STATE WELL NO. 9/2W-15K  
COUNTY Marion  
APPLICATION NO. GR-3689

MARI.....  
14175  
MARI

OWNER: Edwin and Virginia Keech  
dba Prairie Farms


MAILING ADDRESS: 1005 Capitol Towers

LOCATION OF WELL: Owner's No.

CITY AND STATE: Salem, Oregon

NW 1/4 SE 1/4 Sec. 15 T. 9 S., R. 2 W., W.M.

Bearing and distance from section or subdivision  
corner 2100 feet North and 2250 feet West of SE  
Corner, Section 15.

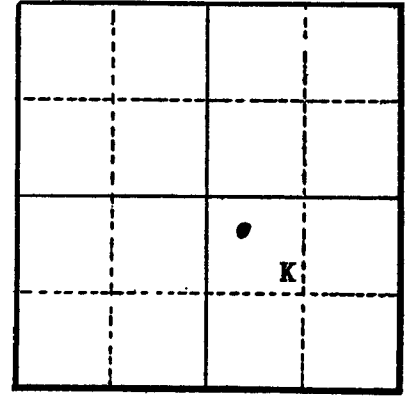

Section 15

Altitude at well

TYPE OF WELL: Drilled Date Constructed 1944

Depth drilled 61 feet Depth cased

### CASING RECORD:

6-inch casing close to bottom

### FINISH:

### AQUIFERS:

### WATER LEVEL:

10 feet

PUMPING EQUIPMENT: Type Jacuzzi Deep Well Pump H.P. 1  
Capacity G.P.M.

### WELL TESTS:

Drawdown ft. after hours G.P.M.  
Drawdown ft. after hours G.P.M.

USE OF WATER Irrigation Temp. °F., 19

SOURCE OF INFORMATION GR-4152

DRILLER or DIGGER Wymore and West

### ADDITIONAL DATA:

Log (NA) Water Level Measurements Chemical Analysis Aquifer Test

### REMARKS: