

STATE ENGINEER
Salem, Oregon

MARI..... **Well Record**

STATE WELL NO. 9/2W-20R(1)
COUNTY Marion
APPLICATION NO. GR-962

Gordon L. Wilcox

GR-933

OWNER: ~~Ralph E. Robertson~~


MAILING ADDRESS: Rt. 1, Box 288R

LOCATION OF WELL: Owner's No. #1

CITY AND STATE: Marion, Oregon

SE ¼ SE ¼ Sec. 20 T. 9 S., R. 2 W., W.M.

Bearing and distance from section or subdivision corner 1200' N. & 350' W. from SE cor. of Sec. 20

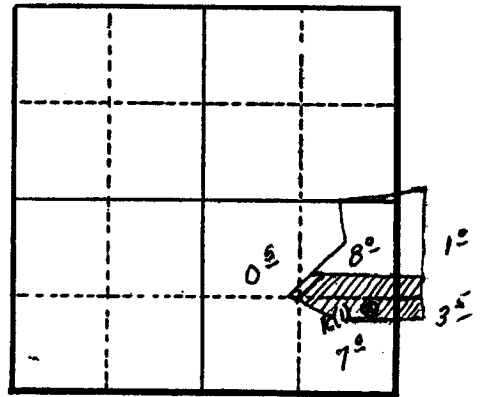

Section 20

Altitude at well 375 ft.

TYPE OF WELL: Drilled Date Constructed 1953

Depth drilled 81 ft. Depth cased 81 ft.

CASING RECORD:

6 inch

FINISH:

Perforated: ½" x 3" from 65 to 81 ft.

AQUIFERS:

WATER LEVEL:

6 ft.

PUMPING EQUIPMENT: Type Jacuzzi H.P. 3

Capacity 120 G.P.M.

WELL TESTS:

Drawdown 8 ft. after hours 120 G.P.M.

Drawdown ft. after hours G.P.M.

USE OF WATER Irrigation Temp. °F. 19

SOURCE OF INFORMATION G.R. Record

DRILLER or DIGGER Marion West

ADDITIONAL DATA:

Log Water Level Measurements Chemical Analysis Aquifer Test

REMARKS:

Log: Rock at 79 ft.
Water bearing at 79 to 81 ft.

Irrigation of 20 acres.