

STATE ENGINEER
Salem, Oregon

Well Record

STATE WELL NO. 9/2W-22
COUNTY MARION
APPLICATION NO. GR-2918

MARI..... ~~14303~~ 14303
MAY 1947

OWNER: Howard T. Clark


MAILING ADDRESS: Rt. 1, Box 47

LOCATION OF WELL: Owner's No.

CITY AND STATE: Turner, Oregon

~~NW~~ ~~SE~~ 22 9 ~~N.~~ 2 ~~E.~~
~~NE~~ 1/4 ~~SE~~ 1/4 Sec. T. S., R. W., W.M.

Bearing and distance from section or subdivision corner A trench 1320' W. and 700' S.

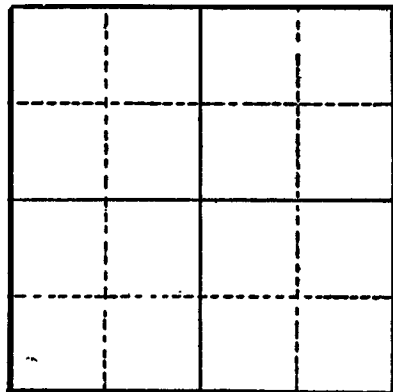

Section

Altitude at well

TYPE OF WELL: trench Date Constructed 1947

Depth drilled Depth cased

CASING RECORD:

FINISH:

AQUIFERS:

WATER LEVEL:

PUMPING EQUIPMENT: Type Pacific H.P. 15
Capacity 700 G.P.M.

WELL TESTS:
Drawdown ft. after hours G.P.M.
Drawdown ft. after hours G.P.M.

USE OF WATER Irrigation Temp. °F., 19.....

SOURCE OF INFORMATION GR-2746

DRILLER or DIGGER

ADDITIONAL DATA:

Log Water Level Measurements Chemical Analysis Aquifer Test

REMARKS: