

STATE ENGINEER
Salem, Oregon

MARI... 14322
MARI
Well Record


STATE WELL NO. 9/2W-22K
COUNTY Marion
APPLICATION NO. GR-3794

OWNER: Alice M. McCoy MAILING ADDRESS: 316 N. Geary St.

LOCATION OF WELL: Owner's No. CITY AND STATE: Albany, Oregon

NW 1/4 SE 1/4 Sec. 22 T. 9 S., R. 2 W., W.M.

Bearing and distance from section or subdivision corner 1419' N. & 1716' W. of SE Cor. Sec. 22

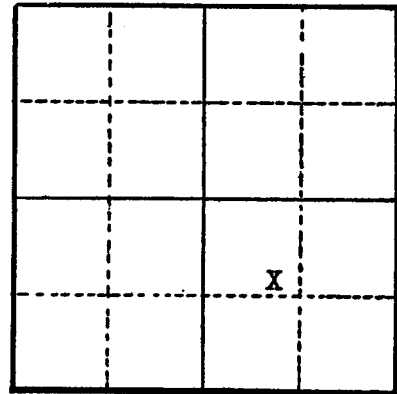

Section 22

Altitude at well

TYPE OF WELL: Dug Date Constructed March, 1945

Depth drilled 4 feet Depth cased

CASING RECORD:

36 inch hole

FINISH:

AQUIFERS:

WATER LEVEL:

PUMPING EQUIPMENT: Type Fairbanks Morse H.P. 20
Capacity 300 G.P.M.

WELL TESTS:

Drawdown ft. after hours G.P.M.
Drawdown ft. after hours G.P.M.

USE OF WATER Irrigation Temp. °F., 19....

SOURCE OF INFORMATION Well Registration Statement

DRILLER or DIGGER George W. McCoy

ADDITIONAL DATA:

Log Water Level Measurements Chemical Analysis Aquifer Test

REMARKS: