

STATE ENGINEER
Salem, Oregon

1434
4771

Well Record


STATE WELL NO. 4/3W-14P(1)
COUNTY Marion
APPLICATION NO. GR-214

OWNER: L. H. & Mary K. Bunning MAILING ADDRESS: _____

LOCATION OF WELL: Owner's No. _____ CITY AND STATE: St. Paul, Oregon

SE $\frac{1}{4}$ SW $\frac{1}{4}$ Sec. 14 T. 4 N. S., R. 2 E. W., W.M.

Bearing and distance from section or subdivision corner 2450' E. & 1050' N. of SW cor. Sec. 14

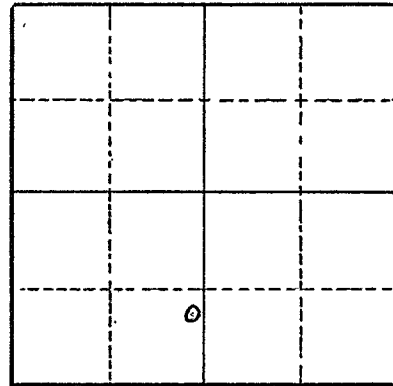

Section 14

Altitude at well 80' Interpolated

TYPE OF WELL: Drilled Date Constructed 2/19/51

Depth drilled 60 Depth cased 55

CASING RECORD:

10 inch casing set from 0 to 55 feet

FINISH:

Perforated from 46 to 55 feet

AQUIFERS:

Gravels depth unknown

WATER LEVEL:

25 feet below land surface 5/1/56

PUMPING EQUIPMENT: Type Fairbanks Morse turbine H.P. 15
Capacity 350 G.P.M.

WELL TESTS:

Drawdown _____ ft. after _____ hours pumping 280 G.P.M.

Drawdown _____ ft. after _____ hours _____ G.P.M.

USE OF WATER Irrigation 16 acres Temp. _____ °F., 19 _____

SOURCE OF INFORMATION Registration Statement GR-214

DRILLER or DIGGER J. T. Miller

ADDITIONAL DATA:

Log No Water Level Measurements _____ Chemical Analysis _____ Aquifer Test _____

REMARKS: