

STATE ENGINEER
Salem, Oregon

Well Record

STATE WELL NO. 9/2W-23cd
COUNTY Marion
APPLICATION NO. GR-630

MARION
14343
MARION


OWNER: K. G. Parker

MAILING ADDRESS: Route 1, Box 130 E
CITY AND STATE: Turner

LOCATION OF WELL: Owner's No.

SE 1/4 SW 1/4 Sec. 23 T. 9 S. R. 2 W., W.M.

Bearing and distance from section or subdivision
corner 25 chains East and 7 chains North of SW
Corner, Section 23

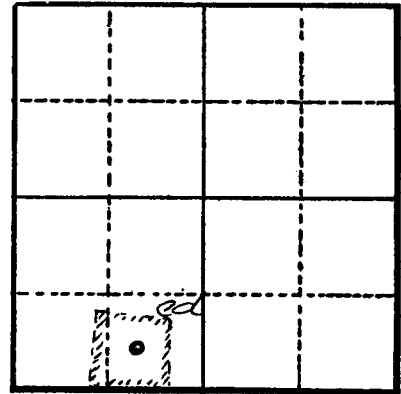

Section 23

Altitude at well

TYPE OF WELL: Sump Date Constructed May 16, 1932

Depth drilled 12 feet Depth cased

CASING RECORD:

175 feet x 10 feet x 12 feet deep sump

FINISH:

AQUIFERS:

WATER LEVEL:

2 1/2 feet

PUMPING EQUIPMENT: Type H.P. 480
Capacity GE 15 G.P.M.

WELL TESTS: 6 480
Drawdown ft. after hours G.P.M.
Drawdown ft. after hours G.P.M.

USE OF WATER Irrigation 19.5 acres Temp. °F. 19

SOURCE OF INFORMATION GR-595

DRILLER or DIGGER

ADDITIONAL DATA:
Log Water Level Measurements Chemical Analysis Aquifer Test

REMARKS: