

STATE ENGINEER
Salem, Oregon

MARI..... Well Record

STATE WELL NO. 9/2W-23A
COUNTY Marion
APPLICATION NO. GR-2655

OWNER: Ralph M. Husted


MAILING ADDRESS: Route 1, Box 178

LOCATION OF WELL: Owner's No.

CITY AND STATE: Turner, Oregon

NE 1/4 NE 1/4 Sec. 23 T. 9 N S, R. 2 E W, W.M.

Bearing and distance from section or subdivision corner 180 ft. W. and 1200 ft. S.

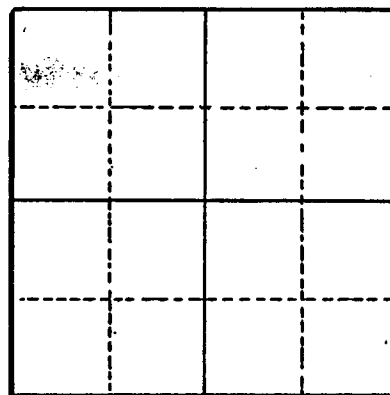

Section

Altitude at well

TYPE OF WELL: drilled Date Constructed 1954

Depth drilled 26' Depth cased 26'

CASING RECORD:

8 inch

FINISH:

AQUIFERS:

WATER LEVEL:

5 feet

PUMPING EQUIPMENT: Type Fairbanks Morse H.P. 15
Capacity 400 G.P.M.

WELL TESTS:

Drawdown 3 ft. after hours pumping 400 G.P.M.
Drawdown ft. after hours G.P.M.

USE OF WATER irrigation Temp. °F. 19

SOURCE OF INFORMATION GR-2517

DRILLER or DIGGER Marion West, Salem, Oregon

ADDITIONAL DATA:

Log Water Level Measurements Chemical Analysis Aquifer Test

REMARKS: