

STATE ENGINEER  
Salem, Oregon

MARI 14349 MARI  
**Well Record**

STATE WELL NO. 9/2W-23G  
COUNTY Marion  
APPLICATION NO. GR-2526

OWNER: Joe L. Hallam


MAILING ADDRESS: Rt. 1, Box 172

LOCATION OF WELL: Owner's No.

CITY AND STATE: Turner, Oregon

SW 1/4 NE 1/4 Sec. 23 T. 9 S., R. 2 W., W.M.

Bearing and distance from section or subdivision corner 1352 ft. West and 1375 ft. South from NE corner Sec. 23.

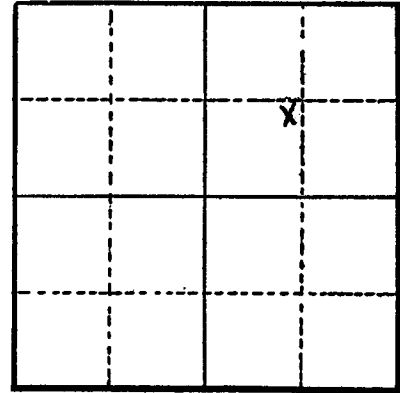

Section 23

Altitude at well

TYPE OF WELL: Dug Date Constructed 6/7/49

Depth drilled 14 Ft. Depth cased

CASING RECORD:

FINISH:

AQUIFERS:

Gravel, rocky, sand

WATER LEVEL:

3 feet below land surface

PUMPING EQUIPMENT: Type centrifugal Denver Gardner Gas H.P. 9  
Capacity 200 G.P.M.

WELL TESTS:

Drawdown 5 ft. after 200 hours 200 G.P.M.  
Drawdown 6 ft. after 200 hours 200 G.P.M.

USE OF WATER Irrigation Temp. °F. 19

SOURCE OF INFORMATION Well Registration Statement

DRILLER or DIGGER Salem Sand & Gravel

ADDITIONAL DATA:

Log X Water Level Measurements Chemical Analysis Aquifer Test

REMARKS:

Top Soil 0-3'  
GRAVEL,  
ROCKY, SAND 3-11'