

STATE ENGINEER  
Salem, Oregon

# Well Record

STATE WELL NO. 9/2W-23H  
COUNTY Marion  
APPLICATION NO. 3525


WARI... 14350  
MARK

OWNER: H. A. Potter MAILING ADDRESS: 2167 NE Park Ave.

LOCATION OF WELL: Owner's No. CITY AND STATE: Salem, Oregon

SE 1/4 NE 1/4 Sec. 23 T. 9 S., R. 2 W., W.M.

Bearing and distance from section or subdivision  
corner 312 ft. West and 2125 ft. South from  
NE corner Section 23

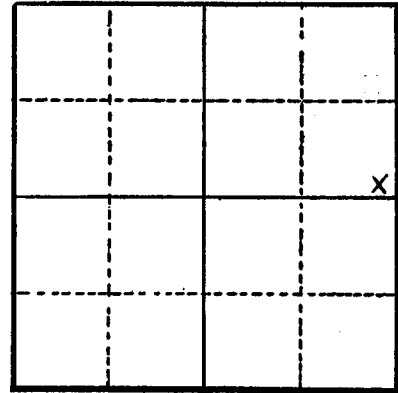

Section 23

Altitude at well

TYPE OF WELL: Dug Date Constructed 6/7/49

Depth drilled 16 ft. Depth cased

### CASING RECORD:

### FINISH:

### AQUIFERS:

Gravel, rock and sand

### WATER LEVEL:

8 feet below surface

PUMPING EQUIPMENT: Type Fairbank & Morse Cent. H.P. Elec. 10 hp  
Capacity G.P.M.

### WELL TESTS:

Drawdown 10 ft. after hours 200 G.P.M.

Drawdown 13 ft. after hours 200 G.P.M.

USE OF WATER Irrigation Temp. °F. 19

SOURCE OF INFORMATION Well Registration Statement

DRILLER or DIGGER - - -

### ADDITIONAL DATA:

Log X Water Level Measurements Chemical Analysis Aquifer Test

### REMARKS:

TOP SOIL, SANDY LOAM 0 to 3'  
GRAVEL, ROCK, SAND 3 to 13'