

STATE ENGINEER
Salem, Oregon

MAR 14 3 31 PM '42

Well Record


STATE WELL NO. 9/2W - 23J
COUNTY MARION
APPLICATION NO. GR-2167

OWNER: Lex C. Rea
MAILING ADDRESS: Rt. 1, Box 163

LOCATION OF WELL: Owner's No.
CITY AND STATE: Turner, Oregon

NE 1/4 SE 1/4 Sec. 23 T. 9 S., R. 2 W., W.M.

Bearing and distance from section or subdivision corner 1100' W., 2050' N.

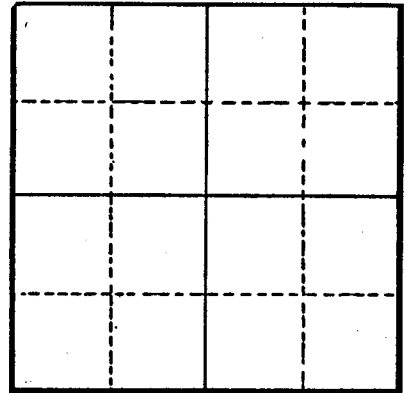

Section

Altitude at well

TYPE OF WELL: Drilled Date Constructed 1948

Depth drilled 30 Depth cased 30

CASING RECORD:

6-Inches

FINISH:

AQUIFERS:

WATER LEVEL:

8-Feet

PUMPING EQUIPMENT: Type Pacific Centrifugal H.P. 5
Capacity 100 G.P.M.

WELL TESTS:

Drawdown ft. after hours G.P.M.
Drawdown ft. after hours G.P.M.

USE OF WATER Irrigation Temp. °F., 19

SOURCE OF INFORMATION GR-2077

DRILLER or DIGGER

ADDITIONAL DATA:

Log Water Level Measurements Chemical Analysis Aquifer Test

REMARKS: