

STATE ENGINEER
Salem, Oregon

14352
MARI...manu

Well Record

STATE WELL NO. 9/2W-23K
COUNTY Marion
APPLICATION NO. GR-1840

GR 1785

OWNER: Melvin Stinnett


MAILING ADDRESS: Rt. 1, Box 161B

LOCATION OF WELL: Owner's No.

CITY AND STATE: Turner, Oregon

NW 1/4 SE 1/4 Sec. 23 T. 9 S., R. 2 W., W.M.

Bearing and distance from section or subdivision corner 1610' W. & 1450' N. from SE cor. Sec. 23

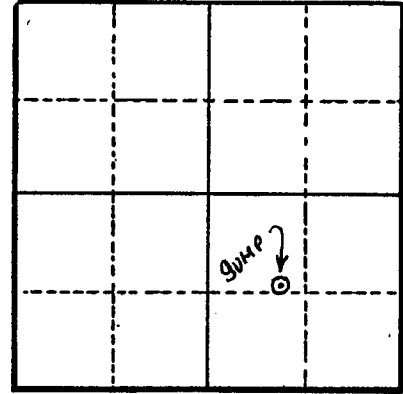

Section 23

Altitude at well

TYPE OF WELL: Dug Date Constructed 1948

Depth drilled 13' Depth cased Sump

CASING RECORD:

Infiltration trench: 75' x 7' x 13'

FINISH:

AQUIFERS:

Sand & gravel

WATER LEVEL:

6' in Summer

PUMPING EQUIPMENT: Type Universal Cent. H.P. 10
Capacity 300 G.P.M.

WELL TESTS:

Drawdown	ft. after	hours	G.P.M.
Drawdown	ft. after	hours	G.P.M.

USE OF WATER Irrigation Temp. °F., 19

SOURCE OF INFORMATION GR Record

DRILLER or DIGGER

ADDITIONAL DATA:

Log N.A. Water Level Measurements Chemical Analysis Aquifer Test

REMARKS:

Irrigation of 16 acres.