


STATE ENGINEER
Salem, Oregon

MARI. 14353 MARL Well Record
GR- 1173

STATE WELL NO. 9/2W-23K
COUNTY Marion
APPLICATION NO. GR- 1213

OWNER: Raymond E. Lambert
LOCATION OF WELL: Owner's No.
MAILING ADDRESS: Rt. 1, Box 162 A
CITY AND STATE: Turner, Oregon

NW 1/4 SE 1/4 Sec. 23 T. 9 S., R. 2 W., W.M.
Bearing and distance from section or subdivision
corner 1750' W. & 470' S. from E1/4 cor. Sec. 23.

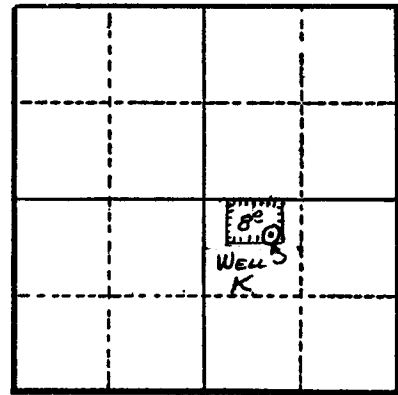

Section 23

Altitude at well 350 ft.

TYPE OF WELL: Dug Date Constructed 1949
Depth drilled 21 ft. Depth cased 18 ft.

CASING RECORD:

36 in. tile from 0 to 18 ft.

FINISH:

AQUIFERS:

WATER LEVEL:

8 ft.

PUMPING EQUIPMENT: Type Homart Cent. 1 1/2 x 1 1/4 in. H.P. 5
Capacity 100 G.P.M.

WELL TESTS:

Drawdown 8 ft. after hours 80 G.P.M.
Drawdown ft. after hours G.P.M.

USE OF WATER Irrigation Temp. °F., 19.

SOURCE OF INFORMATION G. R. Record

DRILLER or DIGGER

ADDITIONAL DATA:

Log Water Level Measurements Chemical Analysis Aquifer Test

REMARKS:

Log: Soil 0 to 3 ft.
Gravel 3 to 21 ft.

Irrigation of 8 acres.