

STATE ENGINEER
Salem, Oregon

Well Record

STATE WELL NO. 9/2W-23K(1)
COUNTY Marion
APPLICATION NO. GR-1108

MARI.MAR
11354


GR-1068

OWNER: Lex C. Rea MAILING ADDRESS: Rt. 1, Box 163

LOCATION OF WELL: Owner's No. CITY AND STATE: North Santiam, Oregon

NW 1/4 SE 1/4 Sec. 23 T. 9 S., R. 2 W., W.M.

Bearing and distance from section or subdivision corner 1860' N. & 300' E. from SE cor. Sec. 23.

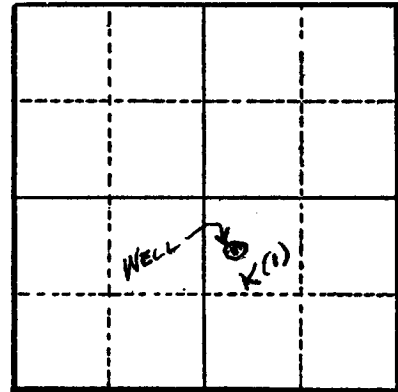

Section 23

Altitude at well 340 ft.

TYPE OF WELL: Dug Date Constructed 1949

Depth drilled 16 ft. Depth cased 5mp

CASING RECORD:

Infiltration trench - 38' x 10' x 16'

FINISH:

AQUIFERS:

WATER LEVEL:

6 ft.

PUMPING EQUIPMENT: Type Pacific 2 in. Cent. H.P. 10

Capacity 200 G.P.M.

WELL TESTS:

Drawdown ft. after hours G.P.M.

Drawdown ft. after hours G.P.M.

USE OF WATER Irrigation Temp. °F., 19

SOURCE OF INFORMATION G. R. Record

DRILLER or DIGGER

ADDITIONAL DATA:

Log N.A. Water Level Measurements Chemical Analysis Aquifer Test

REMARKS:

Irrigation of 12 acres.