

STATE ENGINEER  
Salem, Oregon

# Well Record

STATE WELL NO. 9/2W-24cb  
COUNTY Marion  
APPLICATION NO. GR-860


MARI...  
14387  
MARI

OWNER: Adolph Diercks MAILING ADDRESS: Route 1, Box 155

LOCATION OF WELL: Owner's No. \_\_\_\_\_ CITY AND STATE: Turner

NW  $\frac{1}{4}$  SW  $\frac{1}{4}$  Sec. 24 T. 9 <sup>N.</sup>S., R. 2 <sup>E.</sup>W., W.M.

Bearing and distance from section or subdivision corner 1325 feet West of SW Corner, George Neils DLC

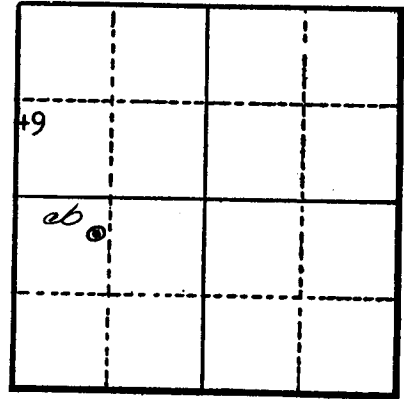

Section 24

Altitude at well 258

TYPE OF WELL: Drilled Date Constructed 1953

Depth drilled 25 feet Depth cased 25 feet

### CASING RECORD:

8-inch 0 to 25 feet

### FINISH:

### AQUIFERS:

### WATER LEVEL:

20

PUMPING EQUIPMENT: Type Fairbanks Morse Centrifugal 3" H.P. 10  
Capacity \_\_\_\_\_ G.P.M.

### WELL TESTS:

Drawdown 3 ft. after \_\_\_\_\_ hours 150 G.P.M.

Drawdown \_\_\_\_\_ ft. after \_\_\_\_\_ hours \_\_\_\_\_ G.P.M.

USE OF WATER Irrigation Temp. \_\_\_\_\_ °F. \_\_\_\_\_, 19\_\_\_\_

SOURCE OF INFORMATION GR-833

DRILLER or DIGGER \_\_\_\_\_

### ADDITIONAL DATA:

Log na Water Level Measurements \_\_\_\_\_ Chemical Analysis \_\_\_\_\_ Aquifer Test \_\_\_\_\_

### REMARKS: