

STATE ENGINEER
Salem, Oregon

Well Record

STATE WELL NO. 9/2W-24cc
COUNTY Marion
APPLICATION NO. GR-480

MARI...
14388
MARI

OWNER: L. H. & Josephine Peters MAILING ADDRESS: _____


LOCATION OF WELL: Owner's No. 1 CITY AND STATE: Stayton, Oregon

SW $\frac{1}{4}$ SW $\frac{1}{4}$ Sec. 24 T. 9 ^{N.} S., R. 2 ^{E.} W., W.M.

Bearing and distance from section or subdivision corner North 87° 53' East 13.5 chains from SW Corner of Section 24

Altitude at well 352 feet Interpolated

TYPE OF WELL: Dug Date Constructed Spring, 1947
Depth drilled 22 feet Depth cased none

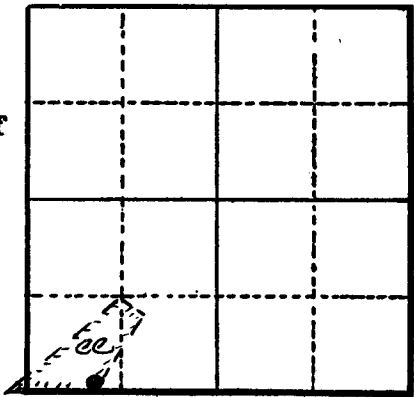

Section 24

CASING RECORD:
none sump 60 x 22 x 30
lg dep wid

FINISH:
none

AQUIFERS:
gravel

WATER LEVEL:
6 to 10 feet below land surface

PUMPING EQUIPMENT: Type 4" Centrifugal H.P. 20
Capacity 504 G.P.M.

WELL TESTS:
Drawdown _____ ft. after _____ hours pumping 504 G.P.M.
Drawdown _____ ft. after _____ hours _____ G.P.M.

USE OF WATER Irrigation 29.99 acres Temp. _____ °F. _____, 19_____

SOURCE OF INFORMATION GR-462

DRILLER or DIGGER _____

ADDITIONAL DATA:
Log no Water Level Measurements _____ Chemical Analysis _____ Aquifer Test _____

REMARKS: