

STATE ENGINEER
Salem, Oregon

MAR 14 3 10
MAR 1

Well Record

STATE WELL NO. 9/2W-24da
COUNTY Marion
APPLICATION NO. GR-481

OWNER: Alford & Lois Schleman

MAILING ADDRESS:

Route 1, Box 102


LOCATION OF WELL: Owner's No.

CITY AND STATE:

Aumsville, Oregon

NE 1/4 SE 1/4 Sec. 24 T. 9 S. R. 2 E. W.M.

Bearing and distance from section or subdivision
corner North 11°10' West 380 feet from the SE
Corner, NE 1/4 SE 1/4 of Section 24

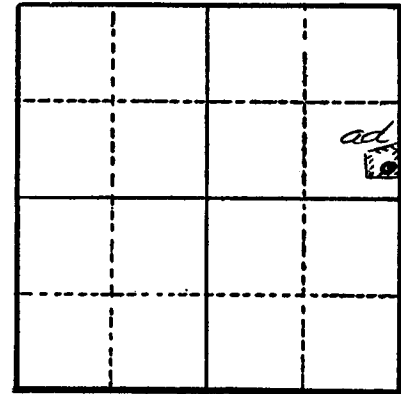

Section 24

Altitude at well 370 feet Interpolated

TYPE OF WELL: Drilled Date Constructed May 1946

Depth drilled 25 Depth cased 25

CASING RECORD:

8-inch casing set from 0 to 25 feet

FINISH:

3/4" x 6" slots from 20 to 25 feet

AQUIFERS:

gravel from 15 to 25 feet

WATER LEVEL:

16 feet below land surface

PUMPING EQUIPMENT: Type

H.P.

Capacity G.P.M.

WELL TESTS:

Drawdown 2 ft. after hours pumping 112 G.P.M.

Drawdown ft. after hours G.P.M.

USE OF WATER Irrigation 4.68 acres Temp. °F. 19

SOURCE OF INFORMATION GR-463

DRILLER or DIGGER

ADDITIONAL DATA:

Log Water Level Measurements Chemical Analysis Aquifer Test

REMARKS:

silt 0 to 10 feet
gravel 10 to 25 feet