

MARI 14392

STATE ENGINEER  
Salem, Oregon

MARI 14392  
MARI 14392  
Well Record

STATE WELL NO. 9/2W-24db  
COUNTY Marion  
APPLICATION NO. GR-157

OWNER: Maynard M. Windsor


MAILING ADDRESS: Route 1, Box 132

LOCATION OF WELL: Owner's No.

CITY AND STATE: Aumsville, Oregon

NW 1/4 SE 1/4 Sec. 24 T. 9 N. S. R. 2 E. W., W.M.

Bearing and distance from section or subdivision corner 1150 feet East and 200 feet South from center of Section 24

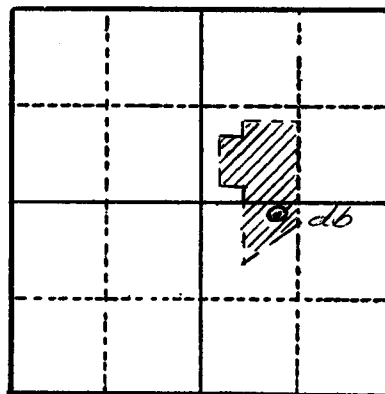

Section 24

Altitude at well 375 feet Interpolated

TYPE OF WELL: Drilled Date Constructed Sept. 1949

Depth drilled 23 feet Depth cased 23 feet

CASING RECORD:

8-inch steel casing set from 6" to 23 feet

FINISH:

torch cut perforations 3/8" wide x set from 3 to 22 feet

AQUIFERS:

unknown

WATER LEVEL:

16 feet below land surface June 1950

PUMPING EQUIPMENT: Type Gould Centrifugal 2" H.P. 7 1/2  
Capacity G.P.M.

WELL TESTS:

Drawdown 1 1/2 ft. after 200 hours G.P.M.  
Drawdown 6" ft. after pumping 120 hours G.P.M.

USE OF WATER Irrigation 22 1/2 acres Temp. °F., 19

SOURCE OF INFORMATION GR-150

DRILLER or DIGGER West & West of Salem, Oregon

ADDITIONAL DATA:

Log no Water Level Measurements Chemical Analysis Aquifer Test

REMARKS:

see hydrograph

STATE ENGINEER  
Salem, Oregon

MARI 14392

State Well No. *9/2W-24K(D)*

County *Marion*

Application No. *GR-157*

### Water Level Record

OWNER: *~~Winson~~ Maynard M. Windsor* OWNER'S NO. *#/*

Description of measuring point: *Top of casing at LSD.*

*See hydrograph*

Date	Water Level Feet (above) (below) Land Surface	Remarks	Date	Water Level Feet (above) (below) Land Surface	Remarks
<i>7-25-57</i>	<i>16.56</i>	<i>JES-WSB</i>			
<i>9-24-57</i>	<i>15.83</i>	<i>WSB</i>			
<i>2-3-61</i>	<i>11.88</i>	<i>WSB</i>			
<i>3-29-61</i>	<i>8.69</i>	<i>WSB</i>			
<i>7-28-61</i>	<i>15.70</i>	<i>WSB</i>			
<i>11-2-61</i>	<i>14.44</i>	<i>WSB &amp; RD</i>			

REMARKS: \_\_\_\_\_  
\_\_\_\_\_  
\_\_\_\_\_