

STATE ENGINEER  
Salem, Oregon


# Well Record

STATE WELL NO. 9/2W-24dd  
COUNTY Marion  
APPLICATION NO. GR-471

MARI... 14396  
MARI

OWNER: Alfred, Carl, and Lucile Hofman  
MAILING ADDRESS: Route 1, Box 109  
CITY AND STATE: Aumsville, Oregon

LOCATION OF WELL: Owner's No. 2  
SE 1/4 SE 1/4 Sec. 24 T. 9 N. S. R. 2 W., W.M.  
Bearing and distance from section or subdivision corner North 61° 38' West 12.38 chains from the SE Corner, Section 24

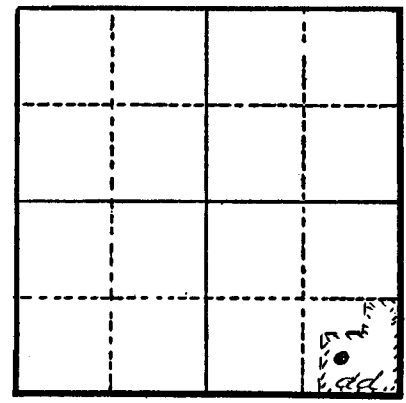

Section 24

Altitude at well 365 feet Interpolated

TYPE OF WELL: Dug & Drilled Date Constructed 1939  
Depth drilled 26 feet Depth cased 26 feet

### CASING RECORD:

24-inch casing set from 0 to 18 feet  
8-inch casing set from 18 to 26 feet

### FINISH:

3/4" x 6" slots set from 18 to 26 feet

### AQUIFERS:

gravel from 18 to 26 feet

### WATER LEVEL:

11 feet below land surface

PUMPING EQUIPMENT: Type 3/2" x 3" Garden & Denver Centrifugal H.P. 15  
Capacity G.P.M.

### WELL TESTS:

Drawdown 1 ft. after hours pumping 272 G.P.M.  
Drawdown ft. after hours G.P.M.

USE OF WATER Irrigation 27 acres Temp. °F. 19  
SOURCE OF INFORMATION GR-453

### DRILLER or DIGGER

### ADDITIONAL DATA:

Log  Water Level Measurements  Chemical Analysis  Aquifer Test

### REMARKS:

sand loam 0 to 8 feet  
gravel 8 to 26 feet