

STATE ENGINEER
Salem, Oregon

Well Record

STATE WELL NO. 9/2W-24C
COUNTY MARION
~~APPLICATION NO.~~ GR-2569


MARI...
14399
MARI

OWNER: H. W. Russell
MAILING ADDRESS: Rt. 1, Box 137 D

CITY AND STATE: Aumsville, Oregon

LOCATION OF WELL: Owner's No. _____
NE 1/4 NW 1/4 Sec. 24 T. 9 S., R. 2 W., W.M.

Bearing and distance from section or subdivision
corner 930' N. of the SW corner of property which is a
point on the W. line of the George Neal D.L.C. being
S. 154° 45' E. 50 chains more or less along D.L.C.
West line

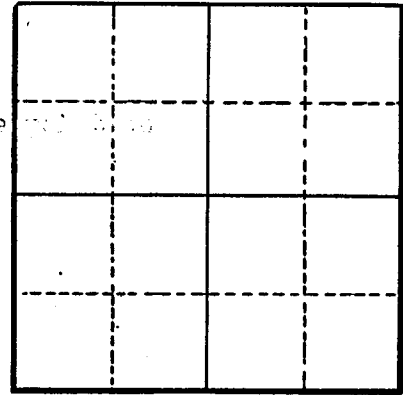

Section

Altitude at well

TYPE OF WELL: Dug Date Constructed 1950

Depth drilled 8 Depth cased

CASING RECORD:

FINISH:

AQUIFERS:

Soil, clay and gravel

WATER LEVEL:

2-feet

PUMPING EQUIPMENT: Type Centrifugal H.P. 7.6
Capacity 150 G.P.M.

WELL TESTS:

Drawdown ft. after hours G.P.M.
Drawdown ft. after hours G.P.M.

USE OF WATER Irrigation Temp. °F., 19

SOURCE OF INFORMATION GR-2428

DRILLER or DIGGER

ADDITIONAL DATA:

Log Water Level Measurements Chemical Analysis Aquifer Test

REMARKS:

Surface soil	clay & gravel	2.5	2.5
Tight clay		1.5	4.0
Gravel		4.0	8.0