

STATE ENGINEER
Salem, Oregon

MARI
14400
MARI

Well Record

STATE WELL NO. 9/2W-24E
COUNTY Marion
APPLICATION NO. GR-3269

OWNER: Harry Weston


MAILING ADDRESS: Route 1, Box 166

LOCATION OF WELL: Owner's No.

CITY AND STATE: Turner, Oregon

SW 1/4 NW 1/4 Sec. 24 T. 9 S., R. 2 W., W.M.

Bearing and distance from section or subdivision corner

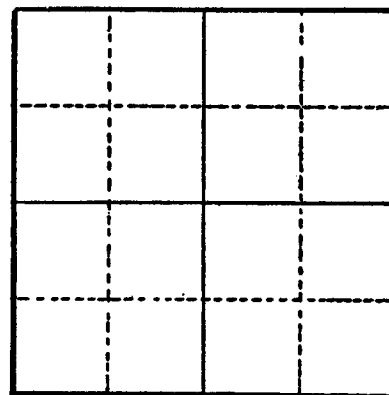

Section 24

Altitude at well

TYPE OF WELL: Drilled Date Constructed 1953

Depth drilled 60 Depth cased

CASING RECORD:

6-inch

FINISH:

Unknown

AQUIFERS:

Unknown

WATER LEVEL:

10 feet

PUMPING EQUIPMENT: Type Fairbanks Morse Jet H.P. 6
Capacity 100 G.P.M.

WELL TESTS:

Drawdown ft. after hours G.P.M.
Drawdown ft. after hours G.P.M.

USE OF WATER Irrigation Temp. °F. 19

SOURCE OF INFORMATION GR-3269

DRILLER or DIGGER

ADDITIONAL DATA:

Log Water Level Measurements Chemical Analysis Aquifer Test

REMARKS: