

STATE ENGINEER  
Salem, Oregon

# Well Record

STATE WELL NO. 9/2N-24E  
COUNTY Marion  
APPLICATION NO. GR-3624


MAR 14 1953  
M APR 1

OWNER: Gordon J. Weitman MAILING ADDRESS: Route 1, Box

LOCATION OF WELL: Owner's No. CITY AND STATE: Turner, Oregon

SW  $\frac{1}{4}$  NW  $\frac{1}{4}$  Sec. 24 T. 9 S, R. 2 W., W.M.

Bearing and distance from section or subdivision corner 370 ft. N. & 900 ft. E. from W  $\frac{1}{4}$  cor.  
Sec. 24

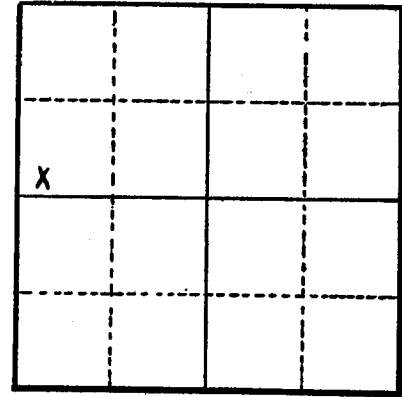

Section 24

Altitude at well \_\_\_\_\_

TYPE OF WELL: drilled Date Constructed Apr., 1953

Depth drilled 61 ft. Depth cased 61 ft.

### CASING RECORD:

8 inch casing set to 61 feet

### FINISH:

### AQUIFERS:

### WATER LEVEL:

10 feet below surface

PUMPING EQUIPMENT: Type Fairbanks Morse Turbine H.P. 6  
Capacity 92 G.P.M.

### WELL TESTS:

Drawdown \_\_\_\_\_ ft. after \_\_\_\_\_ hours \_\_\_\_\_ G.P.M.  
Drawdown \_\_\_\_\_ ft. after \_\_\_\_\_ hours \_\_\_\_\_ G.P.M.

USE OF WATER Irrigation Temp. \_\_\_\_\_ °F. \_\_\_\_\_, 19\_\_\_\_\_

SOURCE OF INFORMATION Well Registration Statement

DRILLER or DIGGER Sanders

### ADDITIONAL DATA:

Log \_\_\_\_\_ Water Level Measurements \_\_\_\_\_ Chemical Analysis \_\_\_\_\_ Aquifer Test \_\_\_\_\_

### REMARKS: