

STATE ENGINEER
Salem, Oregon

MARI...
14403
MARI

Well Record

STATE WELL NO. 9/2W-24H
COUNTY Marion
APPLICATION NO. GR-1605

GR- 1557

OWNER: Honoras H. & Marjorie O. Ralphs


MAILING ADDRESS:

LOCATION OF WELL: Owner's No. #2

CITY AND STATE: Aumsville, Oregon

SE 1/4 NE 1/4 Sec. 24 T. 9 S, R. 2 W., W.M.

Bearing and distance from section or subdivision corner 2643.2' N. & 322.1' W. from SE cor. Sec. 24

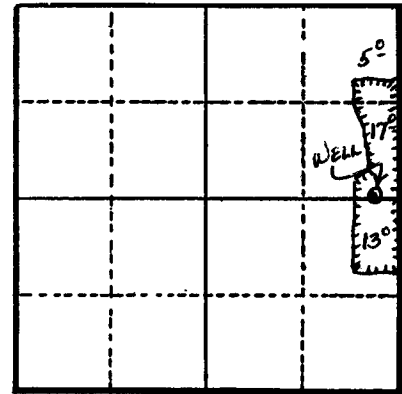

Section 24

Altitude at well 370'

TYPE OF WELL: Drilled Date Constructed 1951

Depth drilled 21' Depth cased 21'

CASING RECORD:

8"

FINISH:

Perforated

AQUIFERS:

WATER LEVEL:

11'

PUMPING EQUIPMENT: Type Berkeley 2" H.P. 10

Capacity 280 G.P.M.

WELL TESTS:

Drawdown 1 ? ft. after hours 450 G.P.M.

Drawdown 7 ft. after hours 225 G.P.M.

USE OF WATER Irrigation Temp. °F. 19

SOURCE OF INFORMATION GR Record

DRILLER or DIGGER Marion West

ADDITIONAL DATA:

Log N.A. Water Level Measurements Chemical Analysis Aquifer Test

REMARKS:

Some info. on strata but no depths

Irrigation of 35 acres.