

STATE ENGINEER
Salem, Oregon

MARI
144024
MARI

Well Record


STATE WELL NO. 9/2W - 24J
COUNTY MARION
APPLICATION NO. GR-2051

OWNER: Ralph E. Glidewell Mailing Address: Rt. 1

LOCATION OF WELL: Owner's No. City and State: Aumsville, Oregon

NE 1/4 SE 1/4 Sec. 24 T. 9 S., R. 2 W., W.M.

Bearing and distance from section or subdivision corner N 30° 30' W. 1815'

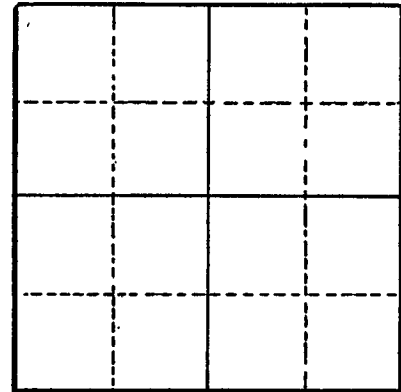

Section

Altitude at well

TYPE OF WELL: Drilled Date Constructed 1945

Depth drilled 21 Depth cased 21

CASING RECORD:

8-inch

FINISH:

Perforations from 10 to 21

AQUIFERS:

Top soil, and gravel

WATER LEVEL:

8-feet

PUMPING EQUIPMENT: Type Centrifugal H.P. 10
Capacity 250 G.P.M.

WELL TESTS:
Drawdown 6 ft. after hours Pumping 350 G.P.M.
Drawdown ft. after hours G.P.M.

USE OF WATER Irrigation Temp. °F. 19

SOURCE OF INFORMATION GR-1977

DRILLER or DIGGER Marion West

ADDITIONAL DATA:

Log Water Level Measurements Chemical Analysis Aquifer Test

REMARKS:

Sandy-alluvial topsoil 8 13
River gravel-(uncemented) 18 --