

STATE ENGINEER
Salem, Oregon

14403
MARION
MARION

Well Record

STATE WELL NO. 9/2W-24J
COUNTY Marion
APPLICATION NO. GR 3318

OWNER: Byrd E. Hendren


MAILING ADDRESS: Stayton

LOCATION OF WELL: Owner's No.

CITY AND STATE: Oregon

NE 1/4 SE 1/4 Sec. 24 T. 9 S., R. 2 W., W.M.

Bearing and distance from section or subdivision corner 1640' N. & 540' E

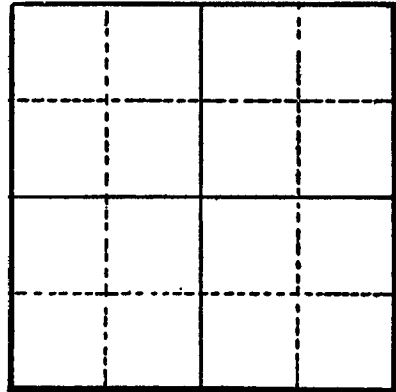

Section

Altitude at well

TYPE OF WELL: drilled Date Constructed 1949

Depth drilled 25' Depth cased 25'

CASING RECORD:

8"

FINISH:

perforated casing from 15' to 25'

AQUIFERS:

WATER LEVEL:

11'

PUMPING EQUIPMENT: Type Fairbanks Morse H.P.
Capacity 275 G.P.M.

WELL TESTS:
Drawdown 3 ft. after hours pumping 216 G.P.M.
Drawdown ft. after hours G.P.M.

USE OF WATER Irrigation Temp. °F., 19

SOURCE OF INFORMATION GR-3079
DRILLER or DIGGER West Well Drilling, 4120 Market Street, Salem, Oregon

ADDITIONAL DATA:
Log Water Level Measurements Chemical Analysis Aquifer Test

REMARKS: