

STATE ENGINEER  
Salem, Oregon

144106  
MAY 21 1943

# Well Record

GR- 1556


STATE WELL NO. 9/2W-24J  
COUNTY Marion  
APPLICATION NO. GR- 1604

OWNER: Honoras H. & Marjorie O. Ralphs MAILING ADDRESS: .....

LOCATION OF WELL: Owner's No. #1 CITY AND STATE: Aumsville, Oregon

NE 1/4 SE 1/4 Sec. 24 T. 9 S., R. 2 W., W.M.

Bearing and distance from section or subdivision corner 2027' N. & 386.3' W. from SE cor. Sec. 24

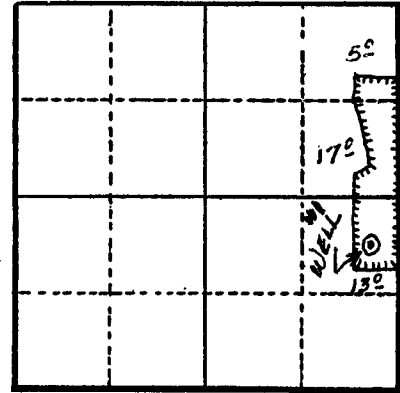

Section 24

Altitude at well 370'

TYPE OF WELL: Drilled Date Constructed 1943

Depth drilled 25' Depth cased 25'

### CASING RECORD:

8"

### FINISH:

Perforated

### AQUIFERS:

### WATER LEVEL:

11'

PUMPING EQUIPMENT: Type Universal H.P. 15

Capacity 450 G.P.M.

### WELL TESTS:

Drawdown 8? ft. after ..... hours 450 G.P.M.

Drawdown 7 ft. after ..... hours 225 G.P.M.

USE OF WATER Irrigation Temp. °F. ...., 19

SOURCE OF INFORMATION GR Record

DRILLER or DIGGER Marion West

### ADDITIONAL DATA:

Log N.A. Water Level Measurements ..... Chemical Analysis ..... Aquifer Test .....

### REMARKS:

Some info. as to types of strata but no depths.

Irrigation of 35 acres.