

STATE ENGINEER
Salem, Oregon

MAR 14 1947
MAR 21

Well Record

GR- 1776


STATE WELL NO. 9/2W-24K
COUNTY Marion
APPLICATION NO. GR- 1831

OWNER: Mary A. Whitlatch
MAILING ADDRESS: Rt. 1, Box 128

LOCATION OF WELL: Owner's No. _____
CITY AND STATE: Aumsville, Oregon

NW 1/4 SE 1/4 Sec. 24 T. 9 S., R. 2 W., W.M.

Bearing and distance from section or subdivision
corner 300' E. & 100' S. from SW cor. DIC # 48

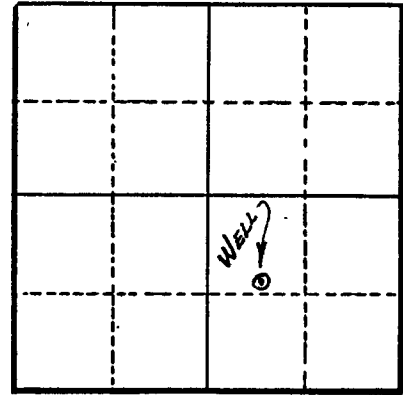

Section 24

Altitude at well 375'

TYPE OF WELL: Drilled Date Constructed 1944

Depth drilled 24' Depth cased 24'

CASING RECORD:

8"

FINISH:

Perforated from 19 to 24 ft.

AQUIFERS:

WATER LEVEL:

14'

PUMPING EQUIPMENT: Type F. M. H.P. 10
Capacity 300 G.P.M.

WELL TESTS:

Drawdown 3 ft. after _____ hours 300 G.P.M.
Drawdown _____ ft. after _____ hours _____ G.P.M.

USE OF WATER Irrigation Temp. °F. 19

SOURCE OF INFORMATION GR Record

DRILLER or DIGGER Marion West

ADDITIONAL DATA:

Log N.A. Water Level Measurements _____ Chemical Analysis _____ Aquifer Test _____

REMARKS:

Irrigation of 19.6 acres.