

STATE ENGINEER  
Salem, Oregon

MARION  
14408  
MARK


# Well Record

STATE WELL NO. 9/2W-24K  
COUNTY MARION  
~~APPLICATION NO.~~ GR-2422

OWNER: William Walter Poole  
MAILING ADDRESS: Rt. 1, Box 126  
CITY AND STATE: Aumsville, Oregon

LOCATION OF WELL: Owner's No. NW 1/4 SE 1/4 Sec. 24 T. 9 S., R. 2 W., W.M.

Bearing and distance from section or subdivision corner N. 26° 15' W. 400' from SW cor., DLC 39

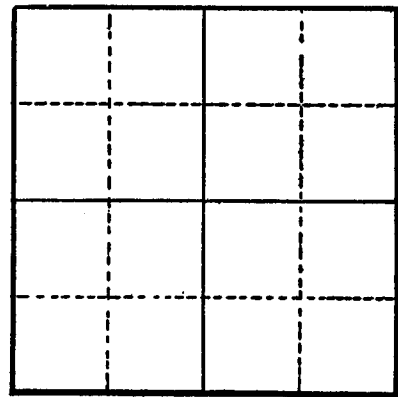

Section .....

Altitude at well .....

TYPE OF WELL: Dug Date Constructed 1946  
Depth drilled 30 Depth cased 30

### CASING RECORD:

46-inch  
8-inch

### FINISH:

3-36' x 48' concrete tile 24' steel casing drilled 6' below casing  
Pump lowered 6' below surface to increase head.

### AQUIFERS:

Loam, boulders, rock and gravel

### WATER LEVEL:

13-feet

PUMPING EQUIPMENT: Type Electric H.P. 10  
Capacity 500 G.P.M.

### WELL TESTS:

Drawdown 5 1/2 ft. after hours Pumping 400 to 600 G.P.M.  
Drawdown ft. after hours G.P.M.

USE OF WATER Irrigation Temp. °F., 19

SOURCE OF INFORMATION GR-2302

DRILLER or DIGGER Wymore on Salem Woodburn highway

### ADDITIONAL DATA:

Log X Water Level Measurements Chemical Analysis Aquifer Test

### REMARKS:

Sandy loam 6' 6'  
large boulders 14' 14' 20'  
smaller rock pea gravel 10' 30'