

STATE ENGINEER
Salem, Oregon

Well Record

STATE WELL NO. 9/2W-24P
COUNTY Marion
APPLICATION NO. GR-3824


MARI...
74413
MARI

OWNER: William Towery MAILING ADDRESS: Route 1, Box 151

LOCATION OF WELL: Owner's No. CITY AND STATE: Turner, Oregon

Well # 1
SE 1/4 SW 1/4 Sec. 24 T. 9 S, R. 2 W., W.M.

Bearing and distance from section or subdivision
corner 160' N. & 320' E. of SE Cor. of SW 1/4 of SW 1/4

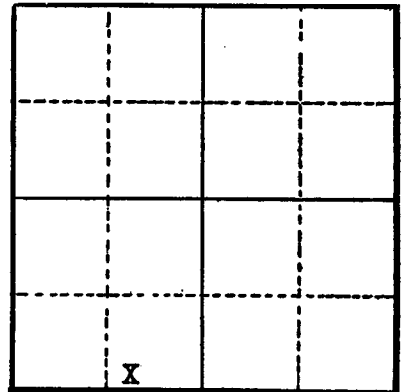

Altitude at well

TYPE OF WELL: Drilled Date Constructed Mar., 1948

Depth drilled 25 feet Depth cased 25 feet

Section 24

CASING RECORD:

8 inch casing set to 25 feet

FINISH:

3 per foot 3/8" x 6" from 10 to 25 feet

AQUIFERS:

WATER LEVEL:

9 feet below surface

PUMPING EQUIPMENT: Type Pacific centrifugal 2" H.P. 10
Capacity 250 G.P.M.

WELL TESTS:

Drawdown 5 ft. after hours 200 G.P.M.
Drawdown ft. after hours G.P.M.

USE OF WATER Irrigation Temp. °F., 19.....

SOURCE OF INFORMATION Well Registration Statement

DRILLER or DIGGER

ADDITIONAL DATA:

Log Water Level Measurements Chemical Analysis Aquifer Test

REMARKS:

Log:	Thickness	Depth to Bottom
Sub soil	6	6
Sand & gravel	10	16
Water gravel	9	25

3485