

STATE ENGINEER
Salem, Oregon

MAR 21.....
MAR 21

Well Record

STATE WELL NO. 9/2W-24P
COUNTY Marion
APPLICATION NO. GR-1431

GR- 1385

OWNER: John A. James

MAILING

ADDRESS:

Rt. 1, Box 124

CITY AND

STATE:


Aumsville, Oregon

LOCATION OF WELL: Owner's No. #1

SE 1/4 SW 1/4 Sec. 24 T. 9 S. R. 2 W., W.M.

Bearing and distance from section or subdivision

corner S. 9°20'E. 4.93 ch. to N. 1/4 cor. Sec. 25.

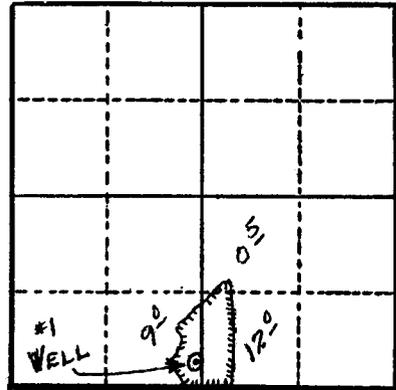

Section 24

Altitude at well 356'

TYPE OF WELL: Drilled Date Constructed 1948

Depth drilled 20.5' Depth cased 20.5'

FINISH:

Perforated: 3/ft. (6" x 1/2") slots from 10' to 20.5'

CASING RECORD

8" steel

AQUIFERS:

WATER LEVEL:

11'

PUMPING EQUIPMENT: Type Pacific 3" Cent. H.P. 15

Capacity 280 G.P.M.

WELL TESTS:

Drawdown ft. after hours G.P.M.

Drawdown ft. after hours G.P.M.

USE OF WATER Irrigation Temp. °F. 19

SOURCE OF INFORMATION GR Record

DRILLER or DIGGER Marion West

ADDITIONAL DATA:

Log Water Level Measurements Chemical Analysis Aquifer Test

REMARKS:

Log: Top soil 0 to 7 ft.
Sand & gravel 7 to 20.5 ft.

Irrigation of 21.5 acres.