

STATE ENGINEER
Salem, Oregon

1442
MAR 1956

Well Record


STATE WELL NO. 4/3W-24G(1)
COUNTY Marion
APPLICATION NO. GR-213

OWNER: L. H. & Mary Bunning MAILING ADDRESS:

LOCATION OF WELL: Owner's No. #1 CITY AND STATE: St. Paul, Oregon

SW 1/4 NE 1/4 Sec. 24 T. 4 S., R. 3 W., W.M.

Bearing and distance from section or subdivision corner 1200' E. & 100' S. from NW cor. of SW 1/4 NE 1/4, Section 24

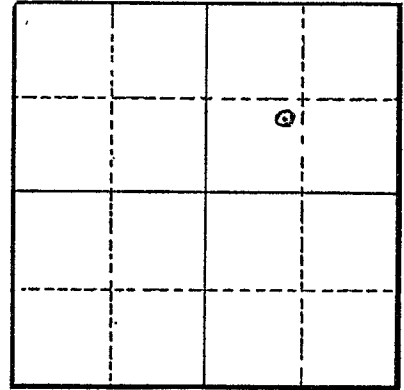

Section 24

Altitude at well 168 feet Interpolated

TYPE OF WELL: Drilled Date Constructed Sept. '49

Depth drilled 121 Depth cased 110

CASING RECORD:

10 inch casing set from 0 to 110 feet

FINISH:

None

AQUIFERS:

Gravel and sand (117 to 121 feet)

WATER LEVEL:

32 feet below land surface 5/1/56

PUMPING EQUIPMENT: Type Peerless turbine H.P. 15
Capacity 250 G.P.M.

WELL TESTS:

Drawdown ft. after hours G.P.M.

Drawdown ft. after hours G.P.M.

USE OF WATER Irrigation 25 acres Temp. °F., 19

SOURCE OF INFORMATION Registration Statement GR-213

DRILLER or DIGGER J. T. Miller, Aurora, Oregon

ADDITIONAL DATA:

Log Water Level Measurements Chemical Analysis Aquifer Test

REMARKS:

0 to 110' No record
110 to 117' No record
117 to 119' Pea gravel
119 to 121' Gravel coarse