

STATE ENGINEER  
Salem, Oregon

*104424*  
*MAR 21..... MAR*  
**Well Record**

STATE WELL NO. 9/2W-25aa  
COUNTY Marion  
APPLICATION NO. GR-472

OWNER: Otto or Madge M. Nelson


MAILING ADDRESS: Route 1, Box 114

LOCATION OF WELL: Owner's No. 1

CITY AND STATE: Aumsville, Oregon

NE 1/4 NE 1/4 Sec. 25 T. 9 S., R. 2 W., W.M.

Bearing and distance from section or subdivision corner North 84°10' East 670 feet to NE Corner, Section 25

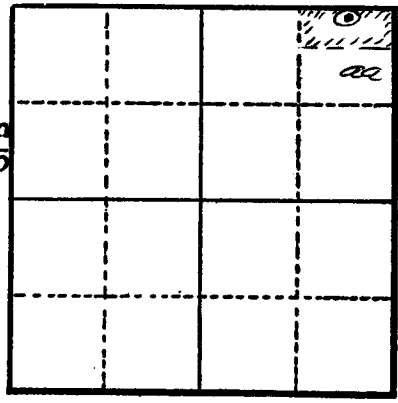

Altitude at well 365 feet Interpolated

TYPE OF WELL: Drilled Date Constructed 1-19-46

Depth drilled 20 feet Depth cased 20 feet

Section 25

**CASING RECORD:**

8-inch casing set from 0 to 20 feet

**FINISH:**

6" x 1/2" slots set from 14 to 20 feet

**AQUIFERS:**

gravel from 3 to 20 feet

**WATER LEVEL:**

10 feet below land surface

PUMPING EQUIPMENT: Type 4" Centrifugal 3" discharge H.P. 15  
Capacity ..... G.P.M.

**WELL TESTS:**

Drawdown 7 ft. after ..... hours pumping 225 G.P.M.  
Drawdown ..... ft. after ..... hours ..... G.P.M.

USE OF WATER Irrigation 16.13 acres Temp. ..... °F. 19

SOURCE OF INFORMATION GR-454

**DRILLER or DIGGER**

**ADDITIONAL DATA:**

Log ..... Water Level Measurements ..... Chemical Analysis ..... Aquifer Test .....

**REMARKS:**

sand loam 0 to 3 feet  
gravel 3 to 20 feet