

STATE ENGINEER
Salem, Oregon

14425
MARI-MARI


Well Record

STATE WELL NO. 9/2W-25aa
COUNTY Marion
APPLICATION NO. GR-472

OWNER: Otto or Madge M. Nelson
MAILING ADDRESS: Route 1, Box 114
CITY AND STATE: Aumsville, Oregon

LOCATION OF WELL: Owner's No. 2
NE 1/4 NE 1/4 Sec. 25 T. 9 N. S. R. 2 E. W.M.

Bearing and distance from section or subdivision
corner North 27°23' East of the NE Corner, Section 25

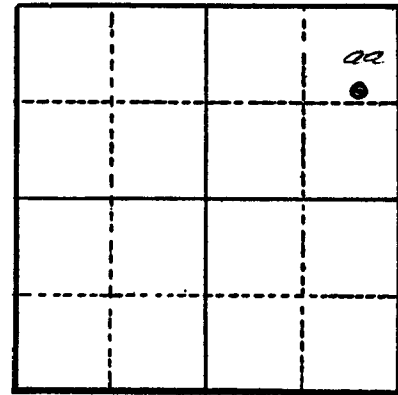

Section 25

Altitude at well 363 feet Interpolated

TYPE OF WELL: Drilled Date Constructed 3-10-41
Depth drilled 26 feet Depth cased 26 feet

CASING RECORD:

8-inch casing set from 0 to 26 feet

FINISH:

6" x 1/2" slots from 20 to 26 feet

AQUIFERS:

gravels from 6 to 26 feet

WATER LEVEL:

6 feet below land surface

PUMPING EQUIPMENT: Type Centrifugal 3/4" pipe H.P. 15
Capacity G.P.M.

WELL TESTS:

Drawdown slight ft. after hours pumping 540 G.P.M.
Drawdown ft. after hours G.P.M.

USE OF WATER Irrigation 27.04 acres Temp. °F. 19

SOURCE OF INFORMATION GR-454

DRILLER or DIGGER

ADDITIONAL DATA:

Log Water Level Measurements Chemical Analysis Aquifer Test

REMARKS:

sand loam 0 to 6 feet
gravel 6 to 26 feet