

STATE ENGINEER
Salem, Oregon

Well Record


STATE WELL NO. 9/2W-25ad
COUNTY Marion
APPLICATION NO. GR-472

MARI...
14427
MAKI

OWNER: Otto Nelson Madge M. Nelson MAILING ADDRESS: Route 1, Box 114

LOCATION OF WELL: Owner's No. 3 CITY AND STATE: Aumsville, Oregon

SE 1/4 NE 1/4 Sec. 25 T. 9 S, R. 2 W., W.M.
Bearing and distance from section or subdivision
corner South 15°53' West 421 feet to SW Corner
of SE 1/4 NE 1/4 of Section 25

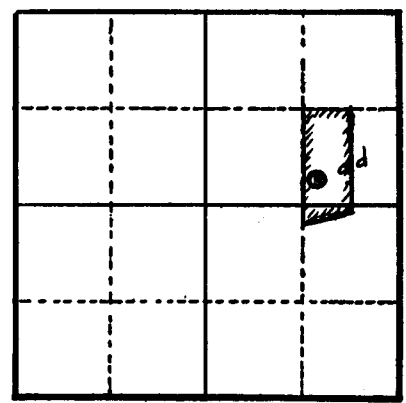

Section 25

Altitude at well 335 feet Interpolated

TYPE OF WELL: Drilled Date Constructed 4-1-55

Depth drilled 26 feet Depth cased 26 feet

CASING RECORD:

8-inch casing set from 0 to 26 feet

FINISH:

6" x 1/2" slots set from 20 to 26 feet

AQUIFERS:

gravel from 3 to 26 feet

WATER LEVEL:

6 feet below land surface

PUMPING EQUIPMENT: Type 3" x 4" Centrifugal H.P. 10
Capacity G.P.M.

WELL TESTS:

Drawdown 3 ft. after hours pumping 384 G.P.M.
Drawdown ft. after hours G.P.M.

USE OF WATER Irrigation 15.31 acres Temp. °F., 19

SOURCE OF INFORMATION GR-454

DRILLER or DIGGER

ADDITIONAL DATA:
Log Water Level Measurements Chemical Analysis Aquifer Test

REMARKS:

sand loam 0 to 3 feet
gravel 3 to 26 feet