

STATE ENGINEER  
Salem, Oregon

# Well Record

STATE WELL NO. 9/2W-25C  
COUNTY Marion  
APPLICATION NO. GR-3828

MAR. 1947  
4431  
MARK

OWNER: William Towery


MAILING ADDRESS: Route 1, Box 151

LOCATION OF WELL: Owner's No. \_\_\_\_\_

CITY AND STATE: Turner, Oregon

Well # 5  
NE 1/4 NW 1/4 Sec. 25 T. 9 S. R. 2 W., W.M.

Bearing and distance from section or subdivision  
corner 289' W. & 700' S. of NE Cor. of NE 1/4 of  
NW 1/4

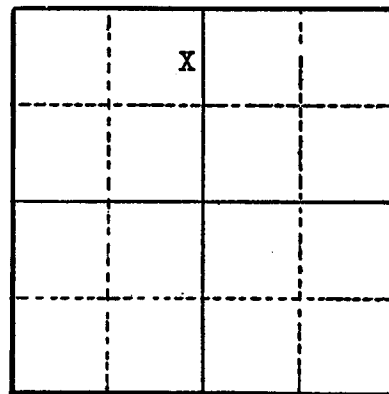

Section 25

Altitude at well \_\_\_\_\_

TYPE OF WELL: Drilled Date Constructed Apr., 1947

Depth drilled 21 feet Depth cased 21 feet

### CASING RECORD:

8 inch casing set to 21 feet

### FINISH:

3 - 3/8" x 6" per foot from 10 to 21 feet

### AQUIFERS:

### WATER LEVEL:

9 feet below surface

PUMPING EQUIPMENT: Type Fairbanks Morse centrifugal H.P. 15

Capacity 350 G.P.M.

### WELL TESTS:

Drawdown 2.5 ft. after \_\_\_\_\_ hours 450 G.P.M.

Drawdown \_\_\_\_\_ ft. after \_\_\_\_\_ hours \_\_\_\_\_ G.P.M.

USE OF WATER Irrigation Temp. \_\_\_\_\_ °F., 19\_\_\_\_\_

SOURCE OF INFORMATION Well Registration Statement

DRILLER or DIGGER \_\_\_\_\_

### ADDITIONAL DATA:

Log  Water Level Measurements \_\_\_\_\_ Chemical Analysis \_\_\_\_\_ Aquifer Test \_\_\_\_\_

### REMARKS:

Log:

Sub soil  
Sand & gravel  
Water gravel

| Thickness | Depth to Bottom |
|-----------|-----------------|
| 3         | 3               |
| 7         | 10              |
| 11        | 21              |