

STATE ENGINEER
Salem, Oregon

MARI.....
14432
MARI
Well Record


STATE WELL NO. 9/2W-25C
COUNTY Marion
APPLICATION NO. GR-3825

OWNER: William Towery

MAILING ADDRESS: Route 1, Box 151
CITY AND STATE: Turner, Oregon

LOCATION OF WELL: Owner's No. Well # 2
NE 1/4 NW 1/4 Sec. 25 T. 9 S. R. 2 W., W.M.

Bearing and distance from section or subdivision corner 155' E. & 860' S. of NE Cor. of NW 1/4 of NW 1/4

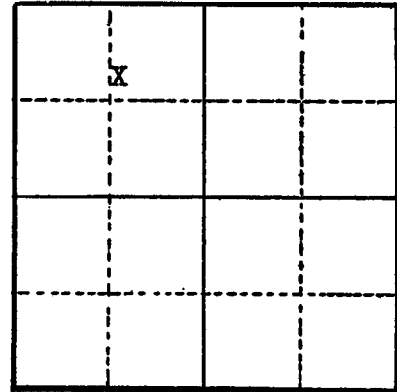

Section 25

Altitude at well

TYPE OF WELL: Drilled Date Constructed Apr., 1949
Depth drilled 21 feet Depth cased 21 feet

CASING RECORD:

8 inch casing set to 21 feet

FINISH:

3 - 3/8" x 6" per foot from 10 to 21 feet

AQUIFERS:

WATER LEVEL:

9 feet below surface

PUMPING EQUIPMENT: Type Cornell centrifugal 3" H.P. 15
Capacity 350 G.P.M.

WELL TESTS:

Drawdown 2.5 ft. after 450 hours G.P.M.
Drawdown ft. after hours G.P.M.

USE OF WATER Irrigation Temp. °F., 19

SOURCE OF INFORMATION Well Registration Statement

DRILLER or DIGGER

ADDITIONAL DATA:

Log X Water Level Measurements Chemical Analysis Aquifer Test

REMARKS:

Log:	Thickness	Depth to Bottom
Sub soil	6	6
Sand and gravel	4	10
Water gravel	11	21