

STATE ENGINEER
Salem, Oregon

MARI...MARI

Well Record

GR- 1386

STATE WELL NO. 9/2W-25B
COUNTY Marion
APPLICATION NO. GR- 1432

OWNER: John A. James


MAILING ADDRESS: Rt. 1, Box 124

LOCATION OF WELL: Owner's No. #2

CITY AND STATE: Aumsville, Oregon

NW 1/4 NE 1/4 Sec. 25 T. 9 S. R. 2 W., W.M.

Bearing and distance from section or subdivision corner N. 54°30' W. 11.8 ch. to NE cor. Sec. 25.

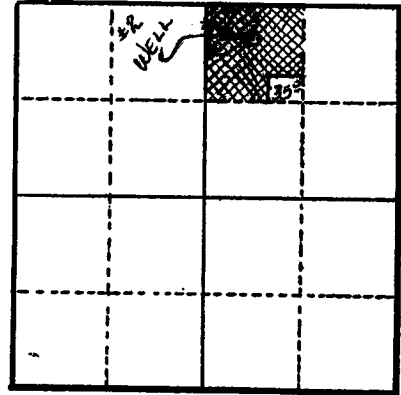

Section 25

Altitude at well

TYPE OF WELL: Drilled Date Constructed 1948

Depth drilled 21' Depth cased 21'

CASING RECORD:

8"

FINISH:

Perforated: 3/ft. (6" x 1/2") from 11' to 21'

AQUIFERS:

WATER LEVEL:

11' (Spring)

PUMPING EQUIPMENT: Type 3" Cent. H.P. 15
Capacity 300 G.P.M.

WELL TESTS:

Drawdown ft. after hours G.P.M.
Drawdown ft. after hours G.P.M.

USE OF WATER Irrigation Temp. °F. 19

SOURCE OF INFORMATION GR Record

DRILLER or DIGGER Marion West

ADDITIONAL DATA:

Log Water Level Measurements Chemical Analysis Aquifer Test

REMARKS:

Log: Top soil 0 to 2 ft.
Sand & gravel 2 to 21 ft.

Irrigation of 35 acres.