

STATE ENGINEER  
Salem, Oregon

14436  
M.A.R. MARK

# Well Record

STATE WELL NO. 9/2W-25E  
COUNTY Marion  
APPLICATION NO. GR-3460

OWNER: Glen Tierce


MAILING ADDRESS: Route 1, Box 150

LOCATION OF WELL: Owner's No.

CITY AND STATE: Turner, Oregon

SW 1/4 NW 1/4 Sec. 25 T. 9 N. 2 E. S., R. W., W.M.

Bearing and distance from section or subdivision corner 2005' S. and 899' E.

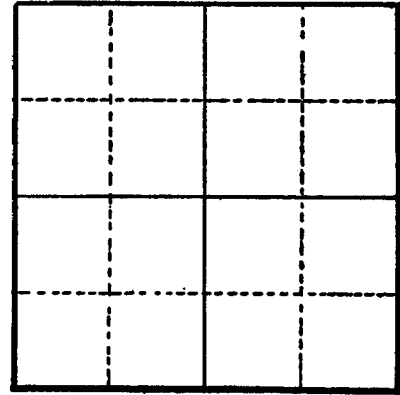

Section

Altitude at well

TYPE OF WELL: drilled Date Constructed 1952

Depth drilled 22' Depth cased 22'

CASING RECORD:

8"

FINISH:

perforated from

AQUIFERS:

gravel

WATER LEVEL:

8'

PUMPING EQUIPMENT: Type 4x3" Fairbanks Morse H.P. 15  
Capacity 450 G.P.M.

WELL TESTS:

Drawdown ft. after hours G.P.M.  
Drawdown ft. after hours G.P.M.

USE OF WATER Irrigation Temp. °F. 19

SOURCE OF INFORMATION GR-3201

DRILLER or DIGGER Marion West Salem, Oregon

ADDITIONAL DATA:

Log  Water Level Measurements Chemical Analysis Aquifer Test

REMARKS:

gravel