

STATE ENGINEER
Salem, Oregon

14437
MAR 1948

Well Record

GR- 1209


STATE WELL NO. 9/2W-25E
COUNTY Marion
APPLICATION NO. GR- 1253

OWNER: Louis C. Scofield
MAILING ADDRESS: Rt. 1, Box 148

LOCATION OF WELL: Owner's No. #2
CITY AND STATE: Turner, Oregon

SW 1/4 NW 1/4 Sec. 25 T. 9 S., R. 2 W., W.M.

Bearing and distance from section or subdivision
corner 1971.3' N. & 537.2' W. to NW cor. Sec. 25.

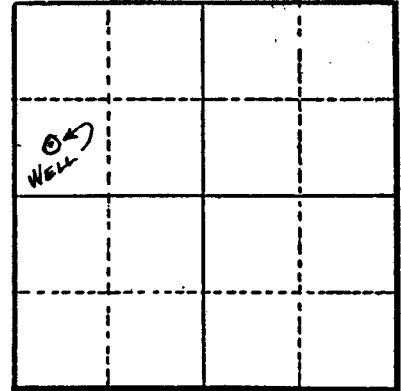

Section 25

Altitude at well 340 ft.

TYPE OF WELL: Drilled Date Constructed 1948

Depth drilled 25 ft. Depth cased 25 ft.

CASING RECORD:

8 inch

FINISH:

Perforated: 4 rows (1/2 x 8 in.) from 13 to 17 ft.
6 rows (1/2 x 8 in.) from 17 to 25 ft.

AQUIFERS:

WATER LEVEL:

11 to 12 ft.

PUMPING EQUIPMENT: Type 3 x 4 in. Cent. H.P. 15

Capacity 400 G.P.M.

WELL TESTS:

Drawdown 3 ft. after 400 hours G.P.M.

Drawdown ft. after hours G.P.M.

USE OF WATER Irrigation Temp. °F. 19

SOURCE OF INFORMATION G. R. Record

DRILLER or DIGGER

ADDITIONAL DATA:

Log N.A. Water Level Measurements Chemical Analysis Aquifer Test

REMARKS:

Irrigation of 45.93 acres.