

STATE ENGINEER
Salem, Oregon

Well Record

STATE WELL NO. 9/2W-25F
COUNTY Marion
APPLICATION NO. GR-3829

MARI...
14438
MARI


OWNER: William Towery

MAILING ADDRESS: Route 1, Box 151

LOCATION OF WELL: Owner's No. CITY AND STATE: Turner, Oregon

Well # 6
SE 1/4 NW 1/4 Sec. 25 T. 9 S., R. 2 W., W.M.

Bearing and distance from section or subdivision corner 660' S. & 300' W. of NE Cor. of SE 1/4 of NW 1/4

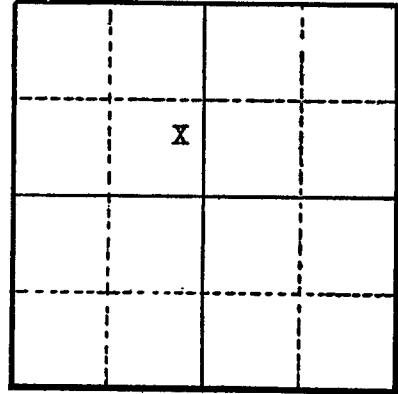

Section 25

Altitude at well

TYPE OF WELL: Drilled Date Constructed Mar., 1947

Depth drilled 21 feet Depth cased 21 feet

CASING RECORD:

8 inch casing set to 21 feet

FINISH:

3 - 3/8" x 6" per foot from 10 to 21 feet

AQUIFERS:

WATER LEVEL:

9 feet below surface

PUMPING EQUIPMENT: Type Pacific centrifugal 3" H.P. 15
Capacity 350 G.P.M.

WELL TESTS:

Drawdown 2.5 ft. after 450 G.P.M.
Drawdown ft. after hours G.P.M.

USE OF WATER Irrigation Temp. °F. 19

SOURCE OF INFORMATION Well Registration Statement

DRILLER or DIGGER

ADDITIONAL DATA:

Log X Water Level Measurements Chemical Analysis Aquifer Test

REMARKS:

Log:

	Thickness	Depth to Bottom
Sub soil	8	8
Sand & gravel	4	12
Water gravel	9	21