

STATE ENGINEER
Salem, Oregon

14439
MARI... ..

Well Record


STATE WELL NO. 9/2W-25F
COUNTY Marion
APPLICATION NO. GR-3826

OWNER: William Towery
MAILING ADDRESS: Route 1, Box 151

LOCATION OF WELL: Owner's No. _____
CITY AND STATE: Turner, Oregon

Well # 3
SW 1/4 NW 1/4 Sec. 25 T. 9 S., R. 2 W., W.M.

Bearing and distance from section or subdivision
corner 155' E. and 577' N. of SW Cor. of SE 1/4 of
NW 1/4

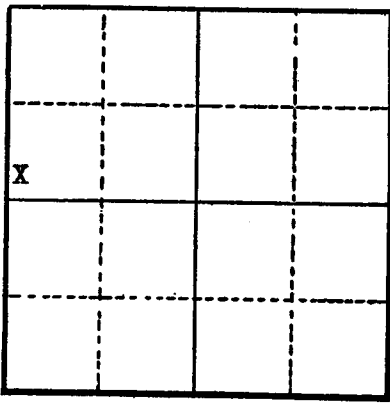

Section 25

Altitude at well _____

TYPE OF WELL: Drilled Date Constructed Nov., 1946

Depth drilled 23 feet Depth cased 23 feet

CASING RECORD:

8 inch casing set to 23 feet

FINISH:

3 - 3/8" x 6" per foot from 10 to 23 feet

AQUIFERS:

WATER LEVEL:

9 feet below surface

PUMPING EQUIPMENT: Type Fairbanks Morse centrifugal 3" H.P. 15
Capacity 350 G.P.M.

WELL TESTS:

Drawdown 2.5 ft. after _____ hours 450 G.P.M.
Drawdown _____ ft. after _____ hours _____ G.P.M.

USE OF WATER Irrigation Temp. _____ °F. _____, 19

SOURCE OF INFORMATION Well Registration Statement

DRILLER or DIGGER _____

ADDITIONAL DATA:

Log Water Level Measurements _____ Chemical Analysis _____ Aquifer Test _____

REMARKS:

Log:	Thickness	Depth to Bottom
Sub soil	6	6
Sand and gravel	5	11
Water gravel	12	23

3487