

STATE ENGINEER **MARI**
 Salem, Oregon **14410**
MARI


Well Record

STATE WELL NO. 9/2W-25G
 COUNTY Marion
 APPLICATION NO. GR-3831

OWNER: William Towery MAILING ADDRESS: Route 1, Box 151
 LOCATION OF WELL: Owner's No. _____ CITY AND STATE: Turner, Oregon

SW 1/4 NE 1/4 Sec. 25 T. 9 S., R. 2 W., W.M.

Bearing and distance from section or subdivision corner 390' S. & 619' W. of SE Cor. of NW 1/4 of NE 1/4

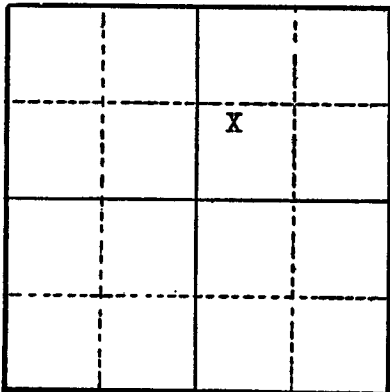

Section 25

Altitude at well _____

TYPE OF WELL: Drilled Date Constructed Sept., 1955
 Depth drilled 22 feet Depth cased 22 feet

CASING RECORD:

8 inch casing set to 22 feet

FINISH:

3 per foot 3/8" x 6" perforations from 10 to 22 feet

AQUIFERS:

WATER LEVEL:

9 feet below surface

PUMPING EQUIPMENT: Type Jacuzzi centrifugal 3" H.P. 15
 Capacity 350 G.P.M.

WELL TESTS:

Drawdown 2.5 ft. after _____ hours 450 G.P.M.
 Drawdown _____ ft. after _____ hours _____ G.P.M.

USE OF WATER Irrigation Temp. _____ °F. _____, 19_____

SOURCE OF INFORMATION Well Registration Statement

DRILLER or DIGGER _____

ADDITIONAL DATA:

Log X Water Level Measurements _____ Chemical Analysis _____ Aquifer Test _____

REMARKS:

Log:	Thickness	Depth to Bottom
Subsoil	6	6
Sand & gravel	5	11
Water gravel	11	22