

STATE ENGINEER
Salem, Oregon

MARKI
MARKI

Well Record


STATE WELL NO. 9/2W - 25H
COUNTY MARION
APPLICATION NO. GR-2048

OWNER: E. D. Glidewell - Leed Glidewell - MAILING ADDRESS: Rt. 1
Ralph E. Glidewell

LOCATION OF WELL: Owner's No. _____ CITY AND STATE: Aumsville, Oregon

SE $\frac{1}{4}$ NE $\frac{1}{4}$ Sec. 25 T. 9 N. S., R. 2 E. W., W.M.

Bearing and distance from section or subdivision corner S 7° 30' W. 2185'

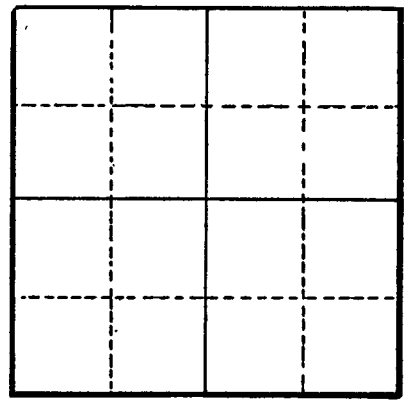

Section _____

Altitude at well _____

TYPE OF WELL: Drilled Date Constructed 1940

Depth drilled 29 Depth cased 29

CASING RECORD:

8-inch

FINISH:

Perforations from 10 to 29

AQUIFERS:

Sandy alluvial top soil, and gravel

WATER LEVEL:

6-feet

PUMPING EQUIPMENT: Type Centrifugal H.P. 15
Capacity 350 G.P.M.

WELL TESTS:
Drawdown 3 ft. after _____ hours Pumping 350 G.P.M.
Drawdown _____ ft. after _____ hours _____ G.P.M.

USE OF WATER Irrigation Temp. _____ °F. _____, 19____

SOURCE OF INFORMATION GR-1974

DRILLER or DIGGER Marion West

ADDITIONAL DATA:

Log Water Level Measurements _____ Chemical Analysis _____ Aquifer Test _____

REMARKS:

Sandy - alluvial - Top soil 8 21
River gravel (uncemented) 21 --