

STATE ENGINEER
Salem, Oregon

14442
MARION

Well Record

GR- 1030

STATE WELL NO. 9/2W-25H(2)
COUNTY Marion
APPLICATION NO. GR- 1068

OWNER: Mrs. Agnes K. Harvey


MAILING ADDRESS: Rt. 1, Box 119

LOCATION OF WELL: Owner's No. #1

CITY AND STATE: Aumsville, Oregon

SE 1/4 NE 1/4 Sec. 25 T. 9 S., R. 2 W., W.M.

Bearing and distance from section or subdivision corner 740' W. & 1400' S. from NE cor. Sec. 25.

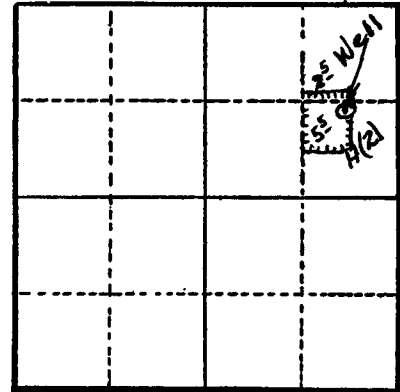

Section 25

Altitude at well 50 ft.

TYPE OF WELL: Drilled Date Constructed 1954

Depth drilled 22 ft. Depth cased _____

CASING RECORD:

8 inch

FINISH:

AQUIFERS:

WATER LEVEL:

12 ft.

PUMPING EQUIPMENT: Type 3" Cent. H.P. 10

Capacity 18,000 G.P.M. Hour

WELL TESTS:

Drawdown _____ ft. after _____ hours _____ G.P.M.

Drawdown _____ ft. after _____ hours _____ G.P.M.

USE OF WATER Irrigation Temp. _____ °F., 19_____

SOURCE OF INFORMATION G.R. Record

DRILLER or DIGGER Marion West

ADDITIONAL DATA:

Log N.A. Water Level Measurements _____ Chemical Analysis _____ Aquifer Test _____

REMARKS:

Irrigation of 8 acres.