

STATE ENGINEER
Salem, Oregon

14444
MAR 1


Well Record

STATE WELL NO. 9/2W-25L
COUNTY Marion
APPLICATION NO. GR-3830

OWNER: William Towery
MAILING ADDRESS: Route 1, Box 151

LOCATION OF WELL: Owner's No. _____
CITY AND STATE: Turner, Oregon

NE 1/4 SW 1/4 Sec. 25 T. 9 S., R. 2 W., W.M.
Bearing and distance from section or subdivision
corner 536' S. & 50' W. of NE Cor. of NE 1/4 of SW 1/4

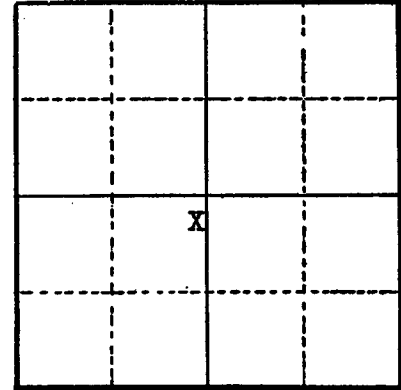

Section 25

Altitude at well _____

TYPE OF WELL: Drilled Date Constructed Nov. 1948
Depth drilled 27 feet Depth cased 27 feet

CASING RECORD:

8 inch casing set to 27 feet

FINISH:

3 - 3/8" x 6" per foot from 10 to 27 feet

AQUIFERS:

WATER LEVEL:

9 feet below surface

PUMPING EQUIPMENT: Type Pacific centrifugal 3" H.P. 15
Capacity 350 G.P.M.

WELL TESTS:

Drawdown 2.5 ft. after _____ hours 450 G.P.M.
Drawdown _____ ft. after _____ hours _____ G.P.M.

USE OF WATER Irrigation Temp. °F. _____, 19

SOURCE OF INFORMATION Well Registration Statement

DRILLER or DIGGER _____

ADDITIONAL DATA:

Log X Water Level Measurements _____ Chemical Analysis _____ Aquifer Test _____

REMARKS:

Log:	Thickness	Depth to Bottom
Subsoil	2	2
Sand & gravel	13	15
Water gravel	12	27